

DEC 27 1999

Approved by Alger County
Land Survey Remonumentation
Peer Group Under Act 345 of
P.A. of 1990 On 12-8-99

Gerald Wilson
Chairman

For corners in SECTION

LAND CORNER RECORDATION CERTIFICATE
Filing Requirement of Act 74, Mich. P.A. 1970

05-165

Alger (County)	Located In:	Corner Code #
1. Public Land Survey	T 48N R 15W	D3
	T _____ R _____	_____
	T _____ R _____	_____
	T _____ R _____	_____
2. Property Controlling in Section	S _____ T _____ R _____	_____
	S _____ T _____ R _____	_____
3. Miscellaneous Property in Section	S _____ T _____ R _____	_____
	S _____ T _____ R _____	_____


FILED
TIME 1:30 pm

DEC 15 1999

DONALD W. KINNUNEN
REGISTER OF DEEDS
ALGER COUNTY, MI

Register of Deeds Stamp & File Number

4. Lot No. _____, Recorded Plat _____
5. Private Claims _____

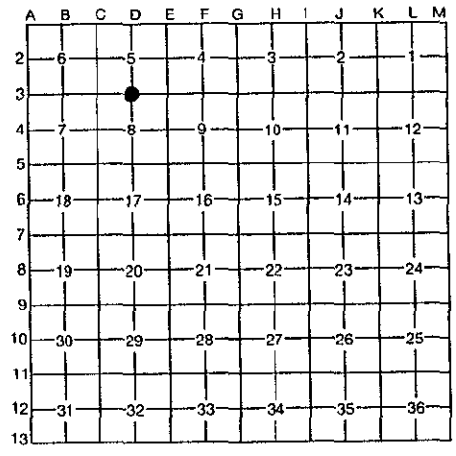

I, Robert L. Jamros, in a field survey on August 16, 1999, 19_____, do hereby state that under requirements of P.A. 74, Michigan P.A. of 1970, the corner points mentioned in lines 1 and 2 above were in conformance with regulations and rules therefore as required in the current manual of survey instructions of the United States Department of the Interior, Bureau of Land Management or by a decree of a Court of Law and/or that the corner points mentioned in lines 3, 4 and 5 above were in conformance with the rules of the Michigan Board of Land Surveyors or by a Decree of a Court of Law; established, re-established, monumented, recovered, found as expressed below:

NOTE: Not more than 2 corners, all in the same town and range, may be recorded on this certificate.

A. Description of original monument and accessories and/or subsequent restoration:

D3: PLS * George E. Adair, DS, 1851. * Set quarter section post. * Hemlock 15", N.50 E., 37 links. * Hemlock 11", S.41 W., 18 links. ***** No other subsequent restoration of record.

B. Description of corner evidence found and/or method applied in restoring or reestablishing corner:

D3: Located corner search area by calculated position and standard field survey. Found only the word "1/4 cor." painted with yellow paint on a cluster of Maples, 12 feet, more or less, Northwesterly of corner position. A search for GLO evidence revealed nothing. Set corner position at midpoint and on line between section corners 1/2 mile East and 1/2 mile West. Corner position as established is accepted as a careful and faithful reestablishment of the position of the original corner.

C. Description of monument for corner and accessories established to perpetuate locating the position of the corner:

D3: Set 2 1/2"x30" Berntsen aluminum monument No. A1NB30 with 3 1/4" aluminum cap stamped to identify corner position. * Established the following reference trees with BT signs, blazed, scribed and painted. * Set PK nails with aluminum I.D. washers for measure in the following: W.Pine 5", S.80 W., 12.19 feet, "1/4s BT". * Maple 12", N.71 W., 38.18 feet, "1/4s BT". * W.Pine 4", N.56 E., 22.28 feet, "BT". * W.Pine 4", S.70 E., 15.87 feet, "BT". * Survey marker sign on 6 foot steel post, N.32 E., 1.1 feet. * All bearings are magnetic.

Signed by *Robert L. Jamros*
Surveyor's Michigan License No. 25849

Date Dec 1999

