

DEC 27 1999

Approved by Alger County
Land Survey Remonumentation
Peer Group Under Act 345 of
P.A. of 1990 On 12-8-99

Harold W. Carlson
Chairman

LAND CORNER RECORDATION CERTIFICATE
Filing Requirement of Act 74, Mich. P.A. 1970

For corners in SECTION

<u>Alger</u> (County)	Located In:	Corner Code #
1. Public Land Survey	T <u>48N</u> R <u>15W</u>	<u>E6</u>
	T _____ R _____	_____
	T _____ R _____	_____
	T _____ R _____	_____
2. Property Controlling in Section	S _____ T _____ R _____	_____
	S _____ T _____ R _____	_____
3. Miscellaneous Property in Section	S _____ T _____ R _____	_____
	S _____ T _____ R _____	_____

05-167

FILED


TIME 1:30 p.m.

DEC 15 1999

DONALD W. KINNUNEN
REGISTER OF DEEDS
ALGER COUNTY, MI
Register of Deeds Stamp & File Number

4. Lot No. _____, Recorded Plat _____
5. Private Claims _____

I, Robert L. Jamros, in a field survey on April 22, 1999, 19_____, do hereby state that under requirements of P.A. 74, Michigan P.A. of 1970, the corner points mentioned in lines 1 and 2 above were in conformance with regulations and rules therefore as required in the current manual of survey instructions of the United States Department of the Interior, Bureau of Land Management or by a decree of a Court of Law and/or that the corner points mentioned in lines 3, 4 and 5 above were in conformance with the rules of the Michigan Board of Land Surveyors or by a Decree of a Court of Law; established, re-established, monumented, _____ recovered, found as expressed below:

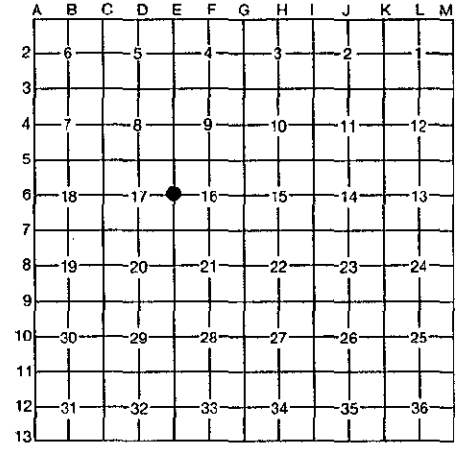

NOTE: Not more than 2 corners, all in the same town and range, may be recorded on this certificate.

A. Description of original monument and accessories and/or subsequent restoration:

E6: PLS * George E. Adair, DS, 1851. * Set quarter section post. * Beech 8", N.5 1/2 E., 12 links. * Beech 9", S.65 1/2 W., 20 links. **** Michigan Department of Conservation, Forestry Division. * Dean C. DeLaMater, RLS, 1953. * This corner was established by single proportionate measurement. * No original evidence, good corners 1/2 mile North and South. * Set 1" iron pipe with 4" brass cap. * 12" W.Pine, S.10 W., 208 links. * 12" W.Pine stump, N.40 E., 34 links. * Liber 2, Page 29, Alger Conty Corner Records. **** No other subsequent restoration of record.

B. Description of corner evidence found and/or method applied in restoring or reestablishing corner:

E6: Located corner search area by calculated position and standard field survey methods. Found 1' iron pipe with 4" brass cap and the BT's of the 1953 report in good condition. Corner position as found lies 0.6 feet east of line and 5.3 feet south of midpoint between section corners 1/2 mile north and 1/2 mile south. Established additional reference trees. Existing corner monument as found is accepted as a careful and faithful reestablishment of the position of the original corner.

C. Description of monument for corner and accessories established to perpetuate locating the position of the corner:

E6: Existing 1' iron pipe with 4" brass cap. * Renewed existing reference trees with BT signs and paint. * Established additional reference trees with BT signs, blazed, scribed and painted. * Set PK nails with aluminum I.D. washers for meausre in the following: Existing - W.Pine 30", S.14 W., 136.82 feet. * Existing W.Pine stump 12", N.42 E., 22.67 feet. * W.Pine 8", N.65 W., 45.30 feet, "1/4s BT". * J.Pine 10", S.81 E., 131.94 feet, "1/4s BT". * Survey marker sign on 6 foot steel post, S.27 E., 1.5 feet. * All bearings are magnetic.

Signed by Robert L. Jamros
Surveyor's Michigan License No. 25849

Date Dec 3, 1999

