

DEC 27 1999

Approved by Alger County
Land Survey Remonumentation
Peer Group Under Act 345 of
P.A. of 1990 On 12-8-1999

Muskel...
Chairman

For corners in

SECTION

LAND CORNER RECORDATION CERTIFICATE
Filing Requirement of Act 74, Mich. P.A. 1970

05-168

Alger (County)	Located In:	Corner Code #
1. Public Land Survey	T 48N R 15W	E7
	T R	
	T R	
	T R	
2. Property Controlling in Section	S T R	
	S T R	
3. Miscellaneous Property in Section	S T R	
	S T R	


FIELD
TIME 1:30 pm

DEC 15 1999

DONALD W. KINNUNEN
REGISTER OF DEEDS
ALGER COUNTY, MI

Register of Deeds Stamp & File Number

4. Lot No. _____, Recorded Plat _____
5. Private Claims _____

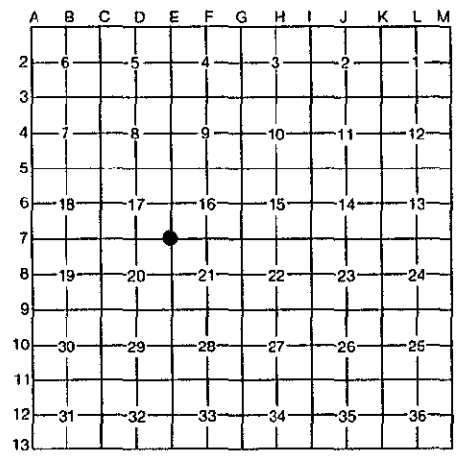

I, Robert L. Jamros, in a field survey on April 22, 1999, 19_____, do hereby state that under requirements of P.A. 74, Michigan P.A. of 1970, the corner points mentioned in lines 1 and 2 above were in conformance with regulations and rules therefore as required in the current manual of survey instructions of the United States Department of the Interior, Bureau of Land Management or by a decree of a Court of Law and/or that the corner points mentioned in lines 3, 4 and 5 above were in conformance with the rules of the Michigan Board of Land Surveyors or by a Decree of a Court of Law; established, re-established, monumented, recovered, found as expressed below:

NOTE: Not more than 2 corners, all in the same town and range, may be recorded on this certificate.

A. Description of original monument and accessories and/or subsequent restoration:


E7: PLS * George E. Adair, DS, 1851. * Set post corner of Sections 16, 17, 20, and 21. * W.Pine 11", S.64 W., 53 links. * W.Pine 36", N.75 E., 20 links. **** Michigan Department of Conservation, Forestry Division. * Dean C. DeLaMater, RLS, 1953. * Corner position set from 1 original BT still in place, in fair condition. * Set 1" iron pipe with 4" brass cap. * 30" W.Pine stump, N.70 W., 91 links. * 36" W.Pine stub, S.40 E., 33 links. * Liber 2, Page 30, Alger County Corner Records. **** C.C.I. Co., Land Corner Records. * Ray J. Brotherton, RLS, 1953. * Found 1" iron pipe with 4" brass cap and GLO original BT's as stumps in NE and SW positions, facings are plain on SW BT stump. * No references given. * Unrecorded. **** No other subsequent restoration of record.

B. Description of corner evidence found and/or method applied in restoring or reestablishing corner:

E7: Located corner search area by calculated position and standard field survey methods. Found 1" iron pipe with 4" brass cap. Also found BT's of the M.D.C.F.D., 1953 report in good condition and the GLO original BT in the Southwest position as a stump. Existing corner monument as found is accepted as a careful and faithful perpetuation of the position of the original corner.

C. Description of monument for corner and accessories established to perpetuate locating the position of the corner:

E7: Existing 1" iron pipe with 4" brass cap., * Renewed existing references with BT signs and paint. * Established additional reference tree with BT signs and paint. * Set PK nails with aluminum I.D washers for measure in the following: W.Pine stump 40", N.74 E., 34.59 feet. * Existing - W.Pine stump 36", S.38 E., 22.94 feet. * Existing - W.Pine stump 14", S.71 W., 35.70 feet. * Existing - W.Pine stump 30", N.65 W., 60.69 feet. * Existing - W.Pine stump 36", N.80 E., 13.30 feet. * Survey marker sign on 6 foot steel post, N.75 W., 1.5 feet. * All bearings are magnetic.

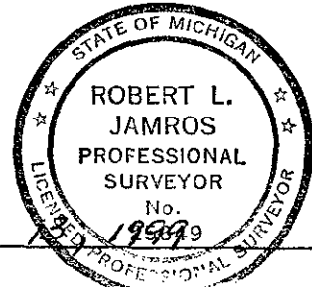

Signed by Robert L. Jamros Date Dec 15 1999
Surveyor's Michigan License No. 25849