

SURVEY & REMONUMENTATION

Approved by Alger County
Land Survey Remonumentation
Peer Group Under Act 345 of
P.A. of 1990 On 5/8 1996

JUL 30 1996

COMMISSION LAND CORNER RECORDATION CERTIFICATE Filing Requirement of Act 74, Mich. P.A. 1970

4-380

For corners in <u>Alger</u> <small>(County)</small>	Located In:	Corner Code #
1. Public Land Survey	T <u>48N</u> R <u>15W</u>	<u>F9</u>
	T _____ R _____	_____
	T _____ R _____	_____
	T _____ R _____	_____
2. Property Controlling in Section	S _____ T _____ R _____	_____
	S _____ T _____ R _____	_____
3. Miscellaneous Property in Section	S _____ T _____ R _____	_____
	S _____ T _____ R _____	_____
4. Lot No. _____, Recorded Plat _____		
5. Private Claims _____		


FILED
TIME 3:00 p.m.

JUN 27 1996

DONALD W. KINNUNEN
REGISTER OF DEEDS
ALGER COUNTY, MI

Register of Deeds Stamp & File Number

I, Robert L. Jamros, in a field survey on October 27, 1995, 19_____, do hereby certify that under requirements of P.A. 74, Michigan P.A. of 1970, the corner points mentioned in lines 1 and 2 above were in conformance with regulations and rules therefore as required in the current manual of survey instructions of the United States Department of the Interior, Bureau of Land Management or by a decree of a Court of Law and/or that the corner points mentioned in lines 3, 4 and 5 above were in conformance with the rules of the Michigan Board of Professional Surveyors or by a Decree of a Court of Law; established, re-established, monumented, re-monumented, recovered, found as expressed below:

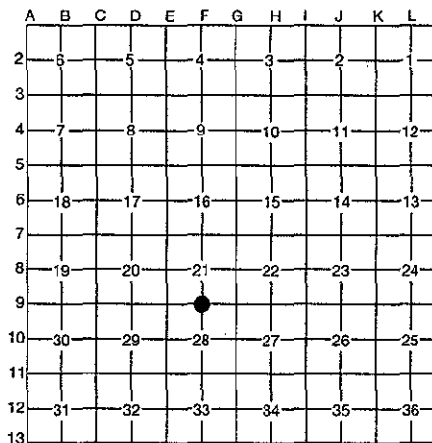

NOTE: Not more than 4 corners, all in the same town and range, may be recorded on this certificate.

A. Description of original monument and accessories and/or subsequent restoration:

F9: PLS-George E. Adair, DS, 1851, Set Qr. section corner - Hemlock 11', N.79 W., 24 links, Hemlock 11', S.86 E., 6 links.***** Department of Conservation, Forestry Division, Billy D. Buckler, RLS, 1960, This corner was re-established midway and on line between two section corners. Found W.Pine stump 9 links north with numerous blazes and notches but no evidence of hemlock bearing trees. Set 1" pipe with 4' brass cap and established the following reference trees, W.Pine Stump 40", S.15 E., 80 links, W.Pine Stump 40", S.85 E., 64 links, W.Pine Stump 40", North, 9 links. Filing No. 158, Alger County Records. No other subsequent restoration.

B. Description of corner evidence found and/or method applied in restoring or reestablishing corner:

F9: Found one inch galvanized iron pipe with four inch brass cap and four inch squared wood post, scribed. Also found two of the 1960 witnesses, White Pine stumps scribed 'NBT'. Monument was set, as stated in 1960 report, midway and on line between section corners. Renewed existing BT stumps and established additional reference trees. Corner position lies 1.79 feet West and 0.33 feet North of the midpoint of a line between Section corners East and West. Monument as set is accepted as a careful and faithful reestablishment of the position of the original corner.

C. Description of monument for corner and accessories established to perpetuate locating the position of the corner:

F9: Stamped P.A. 345 in existing four inch brass capped Department of Conservation Monument. Renewed existing reference stumps w/ BT signs and paint. Established additional reference trees w/ BT signs, blazed, scribed and painted. Set PK nails for measure w/ Alum. I.D. washers in the following reference trees and or stumps. Ex. W.Pine Stump 40", S.15 E., 52.80 feet, " Ex. Scribing NBT ", Ex. W.Pine Stump 40", NORTH, 5.94 feet, " Ex. Scribing NBT ", W.Pine 8", N.02 W., 82.29 feet, " 1/4S BT ", W.Pine 10", S.63 E., 55.02 feet, " 1/4S BT ", Survey marker sign on six foot steel post, S.53 W., 1.1 feet. All bearings are magnetic.

Signed by Robert L. Jamros
Surveyor's Michigan License No. 25849

Date 12 June 1996

