

REMONUMENTATION

JUL 30 1996

COMMISSION

Approved by Alger County
Land Survey Remonumentation
Peer Group Under Act 345 of
P.A. of 1990 On 5/18/1996

Gerald Utulson
Chairman

LAND CORNER RECORDATION CERTIFICATE
Filing Requirement of Act 74, Mich. P.A. 1970

4-376

For corners in
Alger

(County)

Located In:

Corner Code #

- | | | | | | | |
|---|---|-------|---|-------|-------|-------|
| 1. Public Land Survey | T | 48N | R | 15W | F11 | _____ |
| | T | _____ | R | _____ | _____ | _____ |
| | T | _____ | R | _____ | _____ | _____ |
| | T | _____ | R | _____ | _____ | _____ |
| 2. Property Controlling
in Section | S | _____ | T | _____ | R | _____ |
| | S | _____ | T | _____ | R | _____ |
| 3. Miscellaneous
Property in Section | S | _____ | T | _____ | R | _____ |
| | S | _____ | T | _____ | R | _____ |

FILED
TIME 3:00 p.m.

JUN 27 1996

DONALD W. KINNUNEN
REGISTER OF DEEDS
ALGER COUNTY, MI

Register of Deeds Stamp & File Number

4. Lot No. _____, Recorded Plat _____
5. Private Claims _____

A	B	C	D	E	F	G	H	I	J	K	L
2	6	5	4	3	2	1					
3											
4	7	8	9	10	11	12					
5											
6	18	17	16	15	14	13					
7											
8	19	20	21	22	23	24					
9											
10	30	29	28	27	26	25					
11											
12	31	32	33	34	35	36					
13											

Robert L. Jamros, in a field survey on October 27, 1995, 19_____, do hereby certify that under requirements of P.A. 74, Michigan P.A. of 1970, the corner points mentioned in lines 1 and 2 above were in conformance with regulations and rules therefore as required in the current manual of survey instructions of the United States Department of the Interior, Bureau of Land Management or by a decree of a Court of Law and/or that the corner points mentioned in lines 3, 4 and 5 above were in conformance with the rules of the Michigan Board of Professional Surveyors or by a Decree of a Court of Law; established, re-established, monumented, re-monumented, recovered, found as expressed below:

NOTE: Not more than 4 corners, all in the same town and range, may be recorded on this certificate.

A. Description of original monument and accessories and/or subsequent restoration:


F11: PLS-George E. Adair, DS, 1851, Set Qr. section post - W.Pine 18', N.21 E., 28 links, Maple 12', S.20 W., 25 links.***** CCI Forestry Division, Land and Timber Examination Report, Ray J. Brotherton, RLS, 1944, Found HCL post, (Harold C. Lawrence, RLS# 3218), and pine stump BT. No references given. CCI Forestry Division, Land and Timber Examination Report, R.Radcliffe, RLS, 1952, Found HCL post, (Harold C. Lawrence, RLS# 3210), W.Pine and Maple bearing trees. No references given. No other subsequent restoration.

B. Description of corner evidence found and/or method applied in restoring or reestablishing corner:

F11: Set monument from G.L.O. BT positions Northeast and Southwest. In the Northeast BT location found decayed White Pine stump and in the Southwest position found remains of maple roots in stump hole. At 5.75 W., (Magnetic) 7.2 feet found double blazed four inch maple, dead and standing. Old blazes running West and North from corner position. Set corner position S.21 W., 28 links from decayed White Pine stump. Corner position has been verified against corners East and West. Monument as set is accepted as a careful and faithful perpetuation of the position of the original corner.

C. Description of monument for corner and accessories established to perpetuate locating the position of the corner:

F11: Set Berntsen Mon. No. A1NB30, Stamped to identify corner position. Established reference trees w/ BT signs, blazed, scribed and painted. Set Pk nails for measure w/ Alum. I.D. washers in the following reference trees. Maple 7", N.26 W., 43.34 feet, " 1/4s BT ", Maple 5", N.54 E., 58.52 feet, " 1/4s BT ", Maple 6", S.42 E., 49.97 feet, " 1/4s BT ", Maple 7", S.63 W., 43.71 feet, " 1/4s BT ", Survey marker sign on six foot steel post, S.58 W., 1.1 feet. All bearings are magnetic.

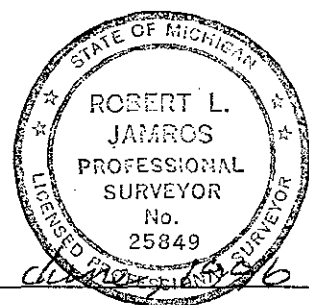

Signed by *Robert L. Jamros*
Surveyor's Michigan License No. 25849

Date 12/27/1996