SURVEY &
REMONUMENTATION

FEB 1 9 1998

SECTION

Approved by Alger County
Land Survey Remonumentation
Peer Group Under Act 315 of
P.A. of 1990 On 12-10 1997
Gerald W Carlson
Chairman

05-51

LAND CORNER RECORDATION CERTIFICATE

Filing Requirement of Act 74, Mich. P.A. 1970

For corners in
Alger
(County)

	Located In:			Corner Code #
1. Public Land Survey	T 48 N	R 15 W		G5
	T ____	R ____		
	T ____	R ____		
	T ____	R ____		
2. Property Controlling	S ____ T ____	R ____		
in Section	S ____ T ____	R ____		
3. Miscellaneous	S ____ T ____	R ____		
Property in Section	S ____ T ____	R ____		

FILED
TIME 8:30 AM
DEC 17 1997
DONALD W. KINNUNEN
REGISTER OF DEEDS
ALGER COUNTY, MI

Register of Deeds Stamp & File Number

4. Lot No. _____, Recorded Plat _____
5. Private Claims _____

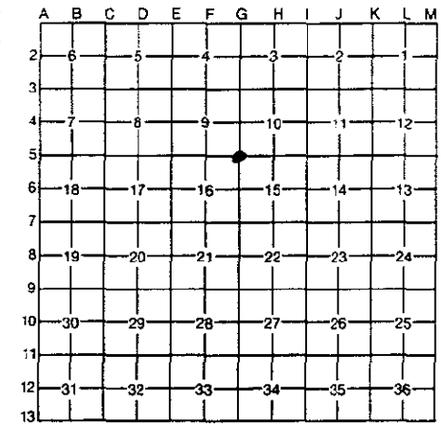

I, Robert L. Jamros, in a field survey on September 17, 1997, 19____, do hereby certify that under requirements of P.A. 74, Michigan P.A. of 1970, the corner points mentioned in lines 1 and 2 above were in conformance with regulations and rules therefore as required in the current manual of survey instructions of the United States Department of the Interior, Bureau of Land Management or by a decree of a Court of Law and/or that the corner points mentioned in lines 3, 4 and 5 above were in conformance with the rules of the Michigan Board of Professional Surveyors or by a Decree of a Court of Law; established, re-established, monumented, re-monumented, recovered, found as expressed below:

NOTE: Not more than 4 corners, all in the same town and range, may be recorded on this certificate.

A. Description of original monument and accessories and/or subsequent restoration:

G5: FLS - George E. Adair, OS, 1851 * Set post at corner of Sections 9, 10, 15 & 16 * White Pine 34, N.44 W., 44 links * White Pine 24, S.54 E., 32 links ***** Dean C. DeLaMater, RLS, Michigan Department of Conservation, 1951 * Corner position recovered and monumented with a 1 inch galv. iron pipe w/4 inch brass cap * 2 original BT's in place, badly burned * Corner had been previously located and perpetuated by R.J. Brotherton, RLS * Witness's - White Pine 12, N.64 W., 407 links * White Pine 14, N.04 E., 336 links * Recorded in Liber 2, Page 11, Alger County records. ***** No other subsequent restoration on record.

B. Description of corner evidence found and/or method applied in restoring or reestablishing corner:

G5: Found 1 inch galv. iron pipe w/brass cap and 4 inch squared post down and decayed * Recovered BT's of the 1951 recorded report * Renewed exist. BT's and established additional reference trees * Monument as found is accepted as a careful and faithful perpetuation of the position of the original corner.

C. Description of monument for corner and accessories established to perpetuate locating the position of the corner:

G5: Exist. 1 inch galv. iron pipe w/brass cap as stamped to identify the corner position * Renewed exist. reference trees w/BT signs and paint * Established additional reference objects w/BT signs, scribed and painted * Set PK nails w/Alum. I.D. washers for measure in the following * Exist. BT, White Pine 36, N.57 W., 269.05 feet * Exist. BT, White Pine 36, N.11 E., 222.4 feet * White Pine stump 40, S.57 E., 182.40 feet, "BT" * White Pine stump 21, S.78 W., 108.26 feet, "BT" * Survey marker sign on 6 foot steel post, N.89 E., 2.0 feet * All bearings are magnetic.

STATE OF MICHIGAN
ROBERT L. JAMROS
PROFESSIONAL SURVEYOR
No. 25049

Signed by Robert L. Jamros Date 12/10/1997

Surveyor's Michigan License No. 25049

FORM APPROVED BY MICHIGAN STATE BOARD OF PROFESSIONAL SURVEYORS, JAN. 28, 1971
REVISED MAY 14, 1975
REVISED JAN. 1992