

DEC 27 1999

Approved by Alger County  
Land Survey Reenumeration  
Peer Group Under Act 345 of  
P.A. of 1990 On 12-8-99

*Heidi Carlson*  
Chairman

05-171

For corners in SECTION

LAND CORNER RECORDATION CERTIFICATE  
Filing Requirement of Act 74, Mich. P.A. 1970

Alger (County)	Located In:	Corner Code #
1. Public Land Survey	T 48N R 15W	G7
	T _____ R _____	_____
	T _____ R _____	_____
	T _____ R _____	_____
2. Property Controlling in Section	S _____ T _____ R _____	_____
	S _____ T _____ R _____	_____
3. Miscellaneous Property in Section	S _____ T _____ R _____	_____
	S _____ T _____ R _____	_____


FILED  
TIME 1:30 p.m.

DEC 15 1999

DONALD W. KINNUNEN  
REGISTER OF DEEDS  
ALGER COUNTY, MI

Register of Deeds Stamp & File Number

- 4. Lot No. \_\_\_\_\_, Recorded Plat \_\_\_\_\_
- 5. Private Claims \_\_\_\_\_

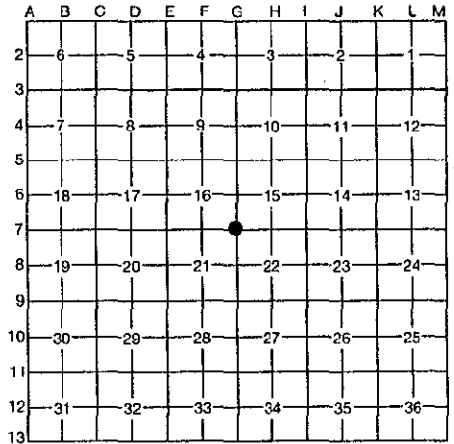

I, Robert L. Janros, in a field survey on June 14, 1999, 19 \_\_\_\_\_, do hereby state that under requirements of P.A. 74, Michigan P.A. of 1970, the corner points mentioned in lines 1 and 2 above were in conformance with regulations and rules therefore as required in the current manual of survey instructions of the United States Department of the Interior, Bureau of Land Management or by a decree of a Court of Law and/or that the corner points mentioned in lines 3, 4 and 5 above were in conformance with the rules of the Michigan Board of Land Surveyors or by a Decree of a Court of Law; established, re-established, monumented, \_\_\_\_\_ recovered, found as expressed below:

NOTE: Not more than 2 corners, all in the same town and range, may be recorded on this certificate.

A. Description of original monument and accessories and/or subsequent restoration:

G7: PLS \* George E. Adair, DS, 1851. \* Set post at corner of Sections 15, 16, 21, and 22, in lake. \* Set witness post 28 links East. \* W.Pine 15", N.70.5 E., 111 links. \* W.Pine 12", S.89 E., 97 links. \*\*\*\* Michigan Department of Conservation, Forestry Division. \* Dean C. DeLaMater, RLS, 1951. \* Set witness corner consisting of a 1/2" iron bar and Cedar post 133 links to East of inaccessible section corner. \* 1 original BT in place for this section corner. \* Witness: 10" W.Pine, S.47 E., 25 links. \* Liber 2, Page 6, Alger County Corner Records. \* Dean C. DeLaMater, RLS, 1951. \* Set witness corner consisting of a 1/2" iron bar and Cedar post 9.71 chains North of inaccessible section corner. \* 1 original BT in place for this section corner. \* Witness: 10" W.Pine, S.52 E., 44 links. \* Liber 2, Page 7, Alger County Corner Records. \*\*\*\* No other subsequent restoration of record.

B. Description of corner evidence found and/or method applied in restoring or reestablishing corner:

G7: Witness corner 133 links East of section corner position of the 1951 report, Liber 2, Page 6, Alger County Corner Records. \* Located corner search area by calculated position and standard field survey methods. Found burnt stub of 10" W.Pine BT, blazes and markings barely visible. 1/2" iron bar and Cedar post have been lost. Set witness corner from 10" W.Pine stub and set new monument and established new references. No GLO evidence remains. \*\*\*\* Witness corner 9.71 chains North of section corner position of the 1951 report, Liber 2, Page 7, Alger County Corner Records. \* Located corner search area by calculated position and standard field survey methods. Found 1/2" iron bar, Cedar post lost. Found stump remains of 10" W.Pine BT. Set new monument over existing 1/2" iron bar and set new references. Section corner position in lake as established by the witness corner is accepted as the best available evidence of the position of the original corner.

C. Description of monument for corner and accessories established to perpetuate locating the position of the corner:

G7: Set (2) 2 1/2"x30" Berntsen aluminum monuments No. A1NB30 with 3 1/4" aluminum caps stamped to identify corner position as 88.1 ft. East (wit. cor. no. 1) and 641.0 feet North (wit. cor. no. 2) of section corner in lake. \* Set monument over existing 1/2" iron bar at wit. cor. no. 2. \* All reference trees have BT signs, blazed, scribed and painted. \* Set PK nails with aluminum I.D. washers for measure in all references. \*\*\*\* Wit. co. no. 1. \* W.Pine 20", S.83 E., 90.12 feet, "BT". \* W.Pine 10", N.41 E., 130.25 feet, "BT". \* Survey marker sign on 6 foot steel post, S.42 E., 1.1 feet. \*\*\*\* Wit. cor. no. 2. \* W.Pine 7", S.81 E., 43.40 feet, "BT". \* J.Pine 6", N.37 E., 39.90 feet, "BT". \* Survey marker sign on 6 foot steel post, N.38 E., 0.80 feet. \* All bearings are magnetic.

Signed by *Robert L. Janros*  
Surveyor's Michigan License No. 25849

Date Dec 13 1999

