

SURVEY & REMONUMENTATION

JUL 30 1996

Approved by Alger County
Land Survey Remonumentation
Peer Group Under Act 345 of
P.A. of 1990 On 5/8 1996

COMMISSION LAND CORNER RECORDATION CERTIFICATE Filing Requirement of Act 74, Mich. P.A. 1970

4-382

Gerald Carlson
Chairman
For corners in

Alger
(County)

Located In:

Corner Code #

FILED
TIME 3:00 p.m.

JUN 27 1996

DONALD W. KINNUNEN
REGISTER OF DEEDS
ALGER COUNTY, MI


Register of Deeds Stamp & File Number

- | | | | | | |
|---|---|------------|---|------------|------------|
| 1. Public Land Survey | T | <u>48N</u> | R | <u>15W</u> | <u>G10</u> |
| | T | | R | | |
| | T | | R | | |
| | T | | R | | |
| 2. Property Controlling
in Section | S | | T | R | |
| | S | | T | R | |
| 3. Miscellaneous
Property in Section | S | | T | R | |
| | S | | T | R | |

4. Lot No. _____, Recorded Plat _____
5. Private Claims _____

I, Robert L. Jamros, in a field survey on October 27, 1995, 19_____, do hereby certify that under requirements of P.A. 74, Michigan P.A. of 1970, the corner points mentioned in lines 1 and 2 above were in conformance with regulations and rules therefore as required in the current manual of survey instructions of the United States Department of the Interior, Bureau of Land Management or by a decree of a Court of Law and/or that the corner points mentioned in lines 3, 4 and 5 above were in conformance with the rules of the Michigan Board of Professional Surveyors or by a Decree of a Court of Law; established, re-established, monumented, re-monumented, recovered, found as expressed below:

NOTE: Not more than 4 corners, all in the same town and range, may be recorded on this certificate.

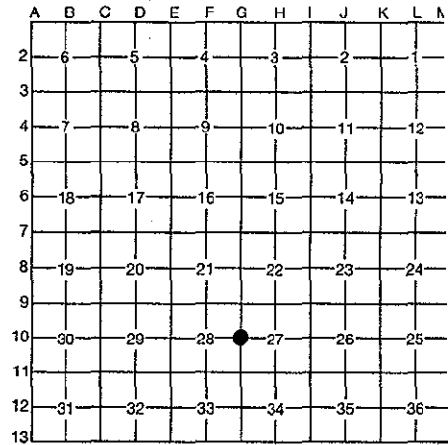

A. Description of original monument and accessories and/or subsequent restoration:

G10: PLS-George E. Adair, DS, 1851, Set qr. section post - Maple 10', S.45 W., 22 links, Hemlock 10", N.87 E., 25 links. **** Department of Conservation, Forestry Division, Billy D. Buckler, RLS, 1960, This corner was re-established midway and on line between two section corners, no evidence of original corner. Set 1" pipe with 4" brass cap and established the following reference trees, W.Pine 8", N.82 E., 13 1/2 links, Hemlock 12", S.72 W., 19 links. Filing No. 167, Alger County Records. No other subsequent restoration.

B. Description of corner evidence found and/or method applied in restoring or reestablishing corner:

G10: Found one inch galvanized iron pipe with four inch brass cap. Also found was two existing BT's as stated in 1960 report. Existing monument was set, as stated in 1960 report, midway and on line between two section corners. Upgraded existing BT's to current Alger County standards and established additional reference trees. Corner position has been verified against corners North and South. Monument as set is accepted as a careful and faithful reestablishment of the position of the original corner.

C. Description of monument for corner and accessories established to perpetuate locating the position of the corner:

G10: Stamped P.A. 345 in existing four inch brass capped Department of Conservation Monument. Renewed existing reference trees w/ BT signs and paint. Established additional reference trees w/ BT signs, blazed, scribed and painted. Set PK nails for measure w/ Alum. I.D. washers in the following reference trees. Ex. Hemlock 20", N.86 E., 9.05 feet, " Obl. Blzd.", Ex. Hemlock 16", S.80 W., 12.96 feet, " Obl. Blzd.", Hemlock 18", S.36 E., 31.37 feet, " 1/4s BT ", Beech 14", N.36 W., 29.35 feet, " 1/4s BT ", Survey marker sign on six foot steel post, S.67 W., 1.0 feet. All bearing are magnetic.



Signed by Robert L. Jamros
Surveyor's Michigan License No. 25849

Date 12/22/1996