

# SURVEY & REMONUMENTATION

JUL 30 1996

Approved by Alger County  
Land Survey Remonumentation  
Peer Group Under Act 245 of  
P.A. of 1990 On 5/18 1996

Arnold W. Carlson  
Chairman

## COMMISSION LAND CORNER RECORDATION CERTIFICATE Filing Requirement of Act 74, Mich. P.A. 1970

4-383

For corners in	Located In:	Corner Code #	
<u>Alger</u> (County)			
1. Public Land Survey	T <u>48N</u> R <u>15W</u>	<u>G11</u>	
	T _____ R _____	_____	
	T _____ R _____	_____	
	T _____ R _____	_____	
2. Property Controlling in Section	S _____ T _____ R _____	_____	
	S _____ T _____ R _____	_____	
3. Miscellaneous Property in Section	S _____ T _____ R _____	_____	
	S _____ T _____ R _____	_____	

FILED  
TIME 3:00 p.m.

JUN 27 1996

DONALD W. KINNUNEN  
REGISTER OF DEEDS  
ALGER COUNTY, MI

Register of Deeds Stamp & File Number

4. Lot No. \_\_\_\_\_, Recorded Plat \_\_\_\_\_  
5. Private Claims \_\_\_\_\_

	A	B	C	D	E	F	G	H	I	J	K	L	M
2	6		5		4		3		2		1		
3													
4	7		8		9		10		11		12		
5													
6	18		17		16		15		14		13		
7													
8	19		20		21		22		23		24		
9													
10	30		29		28		27		26		25		
11													
12	31		32		33		34		35		36		
13													

I, Robert L. Jamros, in a field survey on February 13, 1996, 19\_\_\_\_\_, do hereby certify that under requirements of P.A. 74, Michigan P.A. of 1970, the corner points mentioned in lines 1 and 2 above were in conformance with regulations and rules therefore as required in the current manual of survey instructions of the United States Department of the Interior, Bureau of Land Management or by a decree of a Court of Law and/or that the corner points mentioned in lines 3, 4 and 5 above were in conformance with the rules of the Michigan Board of Professional Surveyors or by a Decree of a Court of Law; established, re-established, monumented, re-monumented, recovered, found as expressed below:

**NOTE: Not more than 4 corners, all in the same town and range, may be recorded on this certificate.**

**A. Description of original monument and accessories and/or subsequent restoration:**


G11: PLS-George E. Adair, DS, 1851, Set post corner of sections 27-28-33-34, Maple 13", N.47 E., 32 links, Y.Birch 26", S.65 W., 32 links.\*\*\*\*\* Department of Conservation, Forestry Division, Dean C. DeLamater, RLS, 1954, Corner was found by forestry division survey crew, while making a partial resurvey of this township. Corner had been previously located and perpetuated by H.C. Lawrence, RLS. Remains of one original BT still in place. Set 1" pipe with 4" brass cap and established the following reference trees, Maple 8", N.38 W., 34 links, W.Pine 14", S.40 E., 52 links. Filing No. 64, Alger County Records. No other subsequent restoration.

**B. Description of corner evidence found and/or method applied in restoring or reestablishing corner:**

G11: Found one inch galvanized iron pipe with four inch brass cap and four inch squared wood post. Also found was two existing BT's as set and stated in 1954 report. Existing monument was set, as stated in 1954 report, from remains of one original bearing tree still in place. Upgraded existing BT's to current Alger County standards and established additional reference trees. Corner position has been verified against corners West and North. Monument is accepted as a careful and faithful perpetuation of the position of the original corner.

**C. Description of monument for corner and accessories established to perpetuate locating the position of the corner:**

G11: Stamped P.A. 345 in existing four inch brass capped Department of Conservation Monument. Renewed existing reference trees w/ BT signs and paint. Established additional reference trees w/ BT signs, blazed, scribed and painted. Set PK nails for measure w/ Alum. I.D. washers in the following reference trees. Ex. Maple 14", N.34 W., 22.29 feet, " one long blz.", Ex. W.Pine 28", S.37 E., 34.81 feet, " one long blz.", Maple 12", N.28 E., 49.88 feet, " S27 BT ", Maple 8", S.52 W., 29.51 feet, " S33 BT ", Survey marker sign on six foot steel post, N.85 E., 0.8 feet. All bearings are magnetic.

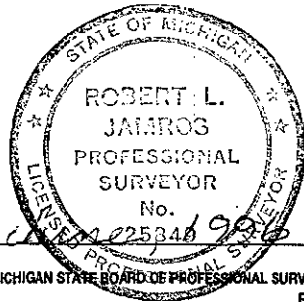

Signed by Robert L. Jamros  
Surveyor's Michigan License No. 25849

Date 12 1996