

**SURVEY &  
REMONUMENTATION**

Approved by Alcona County  
Land Survey Remonumentation  
Peer Group Under Act 845 of  
P.A. of 1990 On 12-10-1997

FEB 19 1998

05-50


Robert L. James  
Chairman

**LAND CORNER RECORDED SECTION CERTIFICATE**  
Filing Requirement of Act 74, Mich. P.A. 1970

For corners in _____	Located In:	Corner Code #
_____ County		
1. Public Land Survey	T <u>48</u> R <u>15</u>	<u>13</u>
	T _____ R _____	_____
	T _____ R _____	_____
	T _____ R _____	_____
2. Property Controlling in Section	S _____ T _____ R _____	_____
	S _____ T _____ R _____	_____
3. Miscellaneous Property in Section	S _____ T _____ R _____	_____
	S _____ T _____ R _____	_____

FILED  
TIME 8:30 A.M.  
  
DEC 17 1997  
  
DONALD W. KINNUNEN  
REGISTER OF DEEDS  
ALGER COUNTY, MI  
Register of Deeds Stamp & File Number

4. Lot No. \_\_\_\_\_, Recorded Plat \_\_\_\_\_  
5. Private Claims \_\_\_\_\_

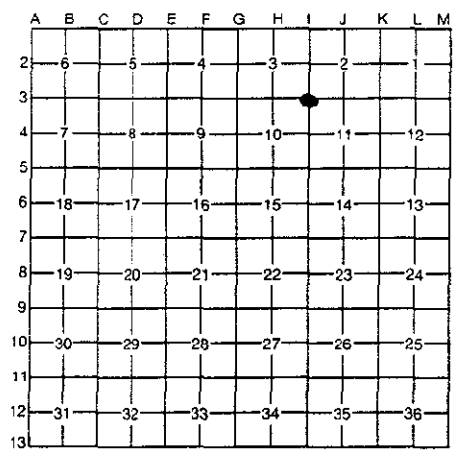

I, Robert L. James, in a field survey on August 11, 1997, 19\_\_\_\_\_, do hereby certify that under requirements of P.A. 74, Michigan P.A. of 1970, the corner points mentioned in lines 1 and 2 above were in conformance with regulations and rules therefore as required in the current manual of survey instructions of the United States Department of the Interior, Bureau of Land Management or by a decree of a Court of Law and/or that the corner points mentioned in lines 3, 4 and 5 above were in conformance with the rules of the Michigan Board of Professional Surveyors or by a Decree of a Court of Law; established, re-established, monumented, re-monumented, recovered, found as expressed below:

**NOTE: Not more than 4 corners, all in the same town and range, may be recorded on this certificate.**

**A. Description of original monument and accessories and/or subsequent restoration:**

13: PLS - George E. Adair, DS, 1851 \* Set quarter section post \* Cedar 15, N.30 W., 55 links \* White Birch 16, S.58 E., 35 links \*\*\*\*\* R.J. Brotherton, RLS, C.C.I. Co., Forestry Division, 1949 \* Set 4 inch post and iron from Government Hemlock remains, S.73 W., 11 links \* Witness's - White Pine 12, N.10 1/2 E., 31 links \* Maple 8, S.02 1/4 W., 46 links \* Beech 12, S.38 E., 22 links \* Beech 10, S.16 W., 50 links \* Unrecorded. \*\*\*\*\* Dean C. DeLaMater, RLS, Michigan Department of Conservation, 1953 \* Recovered and replaced exist. monument with 1 inch galv. pipe w/4 inch brass cap \* Witness's - Beech 12, S.38 E., 32 links \* Beech 10, S.16 W., 50 links \* Recorded in Liber 2, Page 74, Alger County records. \*\*\*\*\* T.J. McLaren, C.C.I. Co., Forestry Division, 1967 \* Recovered exist. monument and witness's made by R.J. Brotherton in 1949 \* Unrecorded. \*\*\*\*\* No other subsequent restoration on record.

**B. Description of corner evidence found and/or method applied in restoring or reestablishing corner:**

13: Found 1 inch galv. iron pipe w/brass cap \* Recovered 3 exist. BT's from 1949 unrecorded report and 1953 recorded report \* Renewed exist. and established new reference trees \* Monument as found is accepted as a careful and faithful perpetuation of the position of the original corner.

**C. Description of monument for corner and accessories established to perpetuate locating the position of the corner:**

13: Exist. 1 inch galv. iron pipe w/brass cap as stamped to identify the corner position \* Renewed exist. reference trees w/BT signs and paint \* Established additional reference trees w/BT signs, blazed, scribed and painted \* Set PK nails w/Alum. I.D. washers for measure in the following - Maple 8, N.58 E., 25.20 feet, '12 BT' \* Beech 8, N.50 W., 23.24 feet, '10 BT' \* Exist. BT, Beech 16, S.29 E., 31.70 feet \* Exist. BT, Beech 16, S.25 W., 33.64 feet \* Maple 22, S.05 E., 30.36 feet, paint only \* Survey marker sign on 6 foot steel post. 15 E., 1.5 feet \* All bearings are magnetic.

Signed by Robert L. James  
Surveyor's Michigan License No. 25849

Date 12/16/1997

