

DEC 27 1999

Approved by Alger County
Land Survey Remonumentation
Peer Group Under Act 345 of
P.A. of 1990 On 12-2-99

Donald W. Kinnunen
Chairman

SECTION

LAND CORNER RECORDATION CERTIFICATE
Filing Requirement of Act 74, Mich. P.A. 1970

For corners in

Alger (County)	Located In:	Corner Code #
1. Public Land Survey	T 48N R 15W	I6
	T R	
	T R	
	T R	
2. Property Controlling in Section	S T R	
	S T R	
3. Miscellaneous Property in Section	S T R	
	S T R	

05-173

FILED


TIME 11:30 AM

DEC 15 1999

DONALD W. KINNUNEN
REGISTER OF DEEDS
ALGER COUNTY, MI

Register of Deeds Stamp & File Number

4. Lot No. _____, Recorded Plat _____
5. Private Claims _____

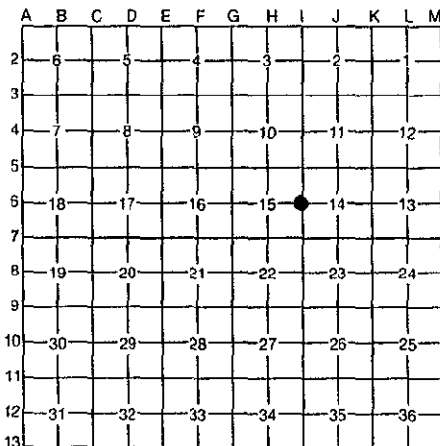

I, Robert L. Jamros, in a field survey on June 08, 1999, 19_____, do hereby state that under requirements of P.A. 74, Michigan P.A. of 1970, the corner points mentioned in lines 1 and 2 above were in conformance with regulations and rules therefore as required in the current manual of survey instructions of the United States Department of the Interior, Bureau of Land Management or by a decree of a Court of Law and/or that the corner points mentioned in lines 3, 4 and 5 above were in conformance with the rules of the Michigan Board of Land Surveyors or by a Decree of a Court of Law; established, re-established, monumented, recovered, found as expressed below:

NOTE: Not more than 2 corners, all in the same town and range, may be recorded on this certificate.

A. Description of original monument and accessories and/or subsequent restoration:

I6: PLS * George E. Adair, DS, 1851. * Set quarter section post. * Hemlock 15', N.39 W., 36 links. * Y.Birch 14", S.49 E., 37 links. ***** Michigan Department of Conservation, Forestry Division. * Dean C. DeLaMeter, RLS, 1951. * This corner was reestablished by proportionate measure. * Set 1" iron pipe with 4" brass cap. * 30" W.Pine stump, S.68 E., 117 links. * 29" W.Pine stump, S.55 W., 108 links. * Liber 2, Page 2, Alger County Corner Records. ***** No other subsequent restoration of record.

B. Description of corner evidence found and/or method applied in restoring or reestablishing corner:

I6: Located corner search area by calculated position and standard field survey methods. Found 1" iron pipe with 4" brass cap and 2 BT's of the 1951 report, in good condition. Existing monument as found lies 1.6 feet east of line and 1.5 feet south of the proportional position between section corners 1/2 mile north and 1/2 mile south. Renewed existing references and established additional references. Existing corner as found is accepted as a careful and faithful reestablishment of the position of the original corner.

C. Description of monument for corner and accessories established to perpetuate locating the position of the corner:

I6: Existing 1" iron pipe with 4" brass cap. * Renewed existing references with BT signs and paint. * Established additional references with BT signs, blazed, scribed and painted. * Set PK nails with aluminum I.D. washers for measure in the following: Existing - 30" W.Pine stump, S.62 E., 76.73 feet. * 29" W.Pine stump, S.62 W., 70.95 feet. * W.Pine 8", N.45 E., 50.67 feet, "1/4s BT". * R.Pine 10", N.77 W., 29.36 feet, "1/4s BT". * Survey marker sign on 6 foot steel post, S.33 W., 1.1 feet. * All bearings are magnetic.

Signed by Robert L. Jamros Date Dec 15 1999
Surveyor's Michigan License No. 75849

