

DEC 27 1999

For corners in

SECTION

Alger
(County)

LAND CORNER RECORDATION CERTIFICATE
Filing Requirement of Act 74, Mich. P.A. 1970

	Located In:	Corner Code #
1. Public Land Survey	T 49N R 15W	17
	T R	
	T R	
	T R	
2. Property Controlling in Section	S T R	
	S T R	
3. Miscellaneous Property in Section	S T R	
	S T R	

Approved by Alger County
Land Survey Remonumentation
Peer Group Under Act 345 of
P.A. of 1990 On 12-8-1999

Paul Utchen
Chairman


05-174

FILED
TIME 1:30 pm.

DEC 15 1999

DONALD W. KINNUNEN
REGISTER OF DEEDS
ALGER COUNTY, MI
Register of Deeds Stamp & File Number

- 4. Lot No. _____, Recorded Plat _____
- 5. Private Claims _____

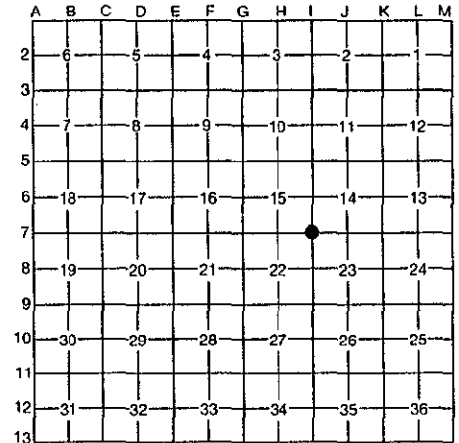

I, Robert L. Jamros, in a field survey on June 08, 1999, 19 _____, do hereby state that under requirements of P.A. 74, Michigan P.A. of 1970, the corner points mentioned in lines 1 and 2 above were in conformance with regulations and rules therefore as required in the current manual of survey instructions of the United States Department of the Interior, Bureau of Land Management or by a decree of a Court of Law and/or that the corner points mentioned in lines 3, 4 and 5 above were in conformance with the rules of the Michigan Board of Land Surveyors or by a Decree of a Court of Law; established, re-established, monumented, recovered, found as expressed below:

NOTE: Not more than 2 corners, all in the same town and range, may be recorded on this certificate.

A. Description of original monument and accessories and/or subsequent restoration:

17: PLS * George E. Adair, DS, 1851. * Set post corner of Sections 14, 15, 22, and 23. * W.Pine 36", N.39 E., 23 links. * Beech 10", S.48 W., 19 links. **** Michigan Department of Conservation, Forestry Division. * Dean C. DeLaMater, RLS, 1951. * Found remains of original stake. * 1 original BT in place, badly burned. * 6" S.Maple, N.70 W., 29 links. * Liber 2, Page 3, Alger County Corner Records. **** No other subsequent restoration of record.

B. Description of corner evidence found and/or method applied in restoring or reestablishing corner:

17: Located corner search area by calculated position and standard field survey methods. Found 1' iron pipe with 4" brass cap. The badly burned original BT is now lost and the BT of the 1951 report is lost also. Established new references. Existing monument as found is accepted as a careful and faithful perpetuation of the position of the original corner.

C. Description of monument for corner and accessories established to perpetuate locating the position of the corner:

17: Existing 1' iron pipe with 4" brass cap. * Established new reference trees with BT signs, blazed, scribed and painted. * Set PK nails with aluminum I.O. washers for measure in the following: R.Pine 10", N.49 W., 25.54 feet, "S15 BT". * W.Pine 7", S.18 W., 45.58 feet. "S22 BT". * Maple 6", S.79 E., 46.59 feet, "S23 BT". * W.Pine 5", N.76 E., 30.75 feet, "S14 BT". * Survey marker sign on 6 foot steel post, N.41 W., 1.4 feet. * All bearings are magnetic.



Signed by *Robert L. Jamros*
Surveyor's Michigan License No. 25849

Date Dec 15 1999