

5-35

Gerald Carlson  
Chairman

**LAND CORNER RECORDATION CERTIFICATE**  
Filing Requirement of Act 74, Mich. P.A. 1970

For corners in ALGER Located in: Corner Code #  
(County)

1. Public Land Survey	T	<u>48N</u>	R	<u>15W</u>	<u>K2</u>
	T		R		
	T		R		
	T		R		
2. Property Controlling in Section	S		T	R	
	S		T	R	
3. Miscellaneous Property in Section	S		T	R	
	S		T	R	

4. Lot No. \_\_\_\_\_, Recorded Plat \_\_\_\_\_  
5. Private Claims \_\_\_\_\_

FILED  
TIME 2:00 p.m.

MAR 31 1997

DONALD W. KINNUNEN  
REGISTER OF DEEDS  
ALGER COUNTY, MI

Register of Deeds Stamp & File Number

I, Robert L. Jamros, in a field survey on October 21, 1996, 19\_\_\_\_\_, do hereby certify that under requirements of P.A. 74, Michigan P.A. of 1970, the corner points mentioned in lines 1 and 2 above were in conformance with regulations and rules therefore as required in the current manual of survey instructions of the United States Department of the Interior, Bureau of Land Management or by a decree of a Court of Law and/or that the corner points mentioned in lines 3, 4 and 5 above were in conformance with the rules of the Michigan Board of Professional Surveyors or by a Decree of a Court of Law; established, re-established, monumented, re-monumented, recovered, found as expressed below:

A	B	C	D	E	F	G	H	I	J	K	L	M
2	6	5	4	3	2	1						
3												
4	7	8	9	10	11	12						
5												
6	18	17	16	15	14	13						
7												
8	19	20	21	22	23	24						
9												
10	30	29	28	27	26	25						
11												
12	31	32	33	34	35	36						
13												

**NOTE: Not more than 4 corners, all in the same town and range, may be recorded on this certificate.**

**A. Description of original monument and accessories and/or subsequent restoration:**

K2: PLS - George E. Adair, DS, 1851, Set quarter Section post \* Beech 18, N.58 E., 45 links \* Sugar 14, S.41 W., 44 links \*\*\*\*\* Ray J. Brotherton, RLS, 1949. Set 3" post from Sugar BT, S.41 W., 44 links. \* C.C.I.Co. Records. \*\*\*\*\* Robert E. Schmeling, RLS, 1980. Observed 14" Sugar BT standing and Brotherton's stake on ground decayed and recovered point in ground where stake was in place. \* Set 1" diam. 4 foot long galvanized iron pipe with brass cap stamped to identify corner position. \* Witness, Hard Maple 8", N.10 W., 7.7 feet, scribed. \* Hard Maple 7", N.66 E., 19.9 feet, scribed. \* Hard Maple 6", S.10 W., 34.5 feet, scribed. \* Beech 14", N.52 W., 44.1 feet, scribed. \* Recorded in L.1, P. 351, Alger County Records. \*\*\*\*\* No other subsequent restoration.


**B. Description of corner evidence found and/or method applied in restoring or reestablishing corner:**

K2: Located existing 1" diam. galvanized iron pipe with brass cap and two existing BT's from the 1980 report. Hard Maple 8", N.10 W., 7.7 feet and Hard Maple 7", N.66 E., 19.9 feet. Other two BT's from 1980 report have been destroyed. \* At S.41 W., 44 links found GLO Sugar BT down and decayed, stump hole still evident. \* Monument as found is accepted as a careful and faithful perpetuation of the position of the original corner.

**C. Description of monument for corner and accessories established to perpetuate locating the position of the corner:**

K2: Stamped P.A. 345 in existing brass capped monument. Renewed existing reference trees w/ BT signs and paint. Established additional reference trees w/ BT signs, blazed, scribed and painted. Set PK nails for measure w/ Alum. I.D. washers in the following reference trees. \* Exist. BT, Maple 10", N.12 W., 7.81 feet, marks still visible. \* Exist. BT, Maple 10", N.70 E., 19.85 feet, marks still visible. \* Beech 12", S.40 E., 23.92 feet, "1/4S BT". \* Spruce 12", S.42 W., 30.40 feet, "1/4S BT". \* Survey marker sign on six foot steel post, S.66 W., 2.0 feet. \* All bearings are magnetic.

Signed by Robert L. Jamros  
Surveyor's Michigan License No. 25489

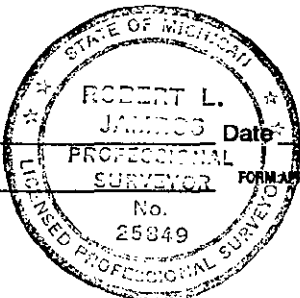

Date 25 March, 1997