

Approved by Alger County
Land Survey Re-monumentation
Peer Group Under Act 345 of
P.A. of 1980 On 3-24-1997

Yerald Carlson
Chairman

LAND CORNER RECORDATION CERTIFICATE
Filing Requirement of Act 74, Mich. P.A. 1970

5-34

For corners in ALGER (County) Located In: Corner Code #

1. Public Land Survey	T	<u>48N</u>	R	<u>15W</u>	<u>K3</u>
	T		R		
	T		R		
	T		R		
2. Property Controlling in Section	S		T		R
	S		T		R
3. Miscellaneous Property in Section	S		T		R
	S		T		R

4. Lot No. _____, Recorded Plat _____

5. Private Claims _____

FILED
TIME 2:00 p.m.
MAR 31 1997
DONALD W. KINNUNEN
REGISTER OF DEEDS
ALGER COUNTY, MI
Register of Deeds Stamp & File Number

I, Robert L. Jamros, in a field survey on October 22, 1996, 19_____, do hereby certify that under requirements of P.A. 74, Michigan P.A. of 1970, the corner points mentioned in lines 1 and 2 above were in conformance with regulations and rules therefore as required in the current manual of survey instructions of the United States Department of the Interior, Bureau of Land Management or by a decree of a Court of Law and/or that the corner points mentioned in lines 3, 4 and 5 above were in conformance with the rules of the Michigan Board of Professional Surveyors or by a Decree of a Court of Law; established, re-established, monumented, re-monumented, recovered, found as expressed below:

A	B	C	D	E	F	G	H	I	J	K	L	M
2	6	5	4	3	2	1						
3												
4	7	8	9	10	11	12						
5												
6	18	17	16	15	14	13						
7												
8	19	20	21	22	23	24						
9												
10	30	29	28	27	26	25						
11												
12	31	32	33	34	35	36						
13												

NOTE: Not more than 4 corners, all in the same town and range, may be recorded on this certificate.

A. Description of original monument and accessories and/or subsequent restoration:

K3: PLS - George E. Adair, DS, 1851, Set post corner of Sections 1-2-11 & 12 * Sugar 16, S.63 E., 17 links * Maple 14, N.44 1/2 W., 28 links ***** Ray J. Brotherton, RLS, 1949. * Set iron and W.Pine post by extending South line of Section 1 a distance of 40.01 chains from the South 1/4 corner west through line tree (Sugar 11') found at 49.31 chains and Fir line tree found at 72.13 chains per original field notes. * Witness, 10' Beech, N.30 W., 15.0 feet and 4' Maple, S.49 E., 26.0 feet. * C.C.I.Co. Records. ***** Robert E. Schmeling, RLS, 1980. * Found restoration work of Mr. Brotherton. Also found top of 5' W.Pine post on ground and point thereof in place. * Paint lines running North, South, East and West. * Set 1 1/2" diam. 4 foot long galvanized iron pipe with brass cap stamped to identify corner position. * Hemlock 10", S.65 E., 53.8 feet, scribed. * Hard Maple 15", S.43 E., 51.8 feet, scribed. * Red Maple 11", S.89 W., 58.8 feet, scribed. * Hard Maple 9", N.35 W., 32.1 feet, scribed. * Recorded in L.1, P.347, Alger County Records. ***** No other subsequent restoration.


B. Description of corner evidence found and/or method applied in restoring or reestablishing corner:

K3: Located existing 1 1/2" diam. galvanized iron pipe with brass cap (badly damaged) with a portion of iron leaf spring at base of existing monument. Also located two existing BT's of the 1980 report. * Of the unrecorded report of 1949 found 10' Beech, N.30 W., 15.0 feet dead, but standing, and the Maple BT in the SE position destroyed. * Replaced existing damaged monument with new monument. * Monument position as found is accepted as a careful and faithful reestablishment of the position of the original corner.

C. Description of monument for corner and accessories established to perpetuate locating the position of the corner:

K3: Set Berntsen Monument No. A1NB30 stamped to identify corner position. * Renewed existing reference trees w/ BT signs and paint. * Established additional reference trees w/ BT signs, blazed, scribed and painted. * Set PK nails for measure w/ Alum. I.D. washers in the following reference trees. * Exist. BT, Maple 24", S.90 W., 57.93 feet, marks still visible. * Exist. BT, Maple 20", S.63 E., 54.25 feet, marks still visible. * Maple 8", N.18 E., 26.80 feet, "S1 BT". * Maple 8", S.08W., 47.61 feet, "S11 BT". * Survey marker sign on six foot steel post, S.69 E., 1.0 feet. * All bearings are magnetic.

Signed by Robert L. Jamros

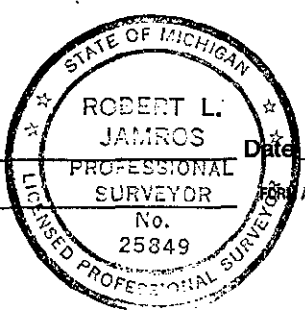

Date 25 March, 1997