

**SURVEY &
REMONUMENTATION**

FEB 19 1998

Approved by Alger County
Land Survey Remonumentation
Peer Group Under Act 343 of
P.A. of 1990 On 12-10-1997

Donald W. Kinnunen
Chairman

**SECTION
LAND CORNER RECORDATION CERTIFICATE
Filing Requirement of Act 74, Mich. P.A. 1970**

05-45

For corners in _____ (County)	Located In:	Corner Code #
	40 15	K5
1. Public Land Survey	T <u>40N</u> R <u>15W</u>	K5
	T _____ R _____	_____
	T _____ R _____	_____
	T _____ R _____	_____
2. Property Controlling in Section	S _____ T _____ R _____	_____
	S _____ T _____ R _____	_____
3. Miscellaneous Property in Section	S _____ T _____ R _____	_____
	S _____ T _____ R _____	_____


FILED
TIME 2:30 A.M.

DEC 17 1997

DONALD W. KINNUNEN
REGISTER OF DEEDS
ALGER COUNTY, MI

Register of Deeds Stamp & File Number

4. Lot No. _____, Recorded Plat _____
5. Private Claims _____

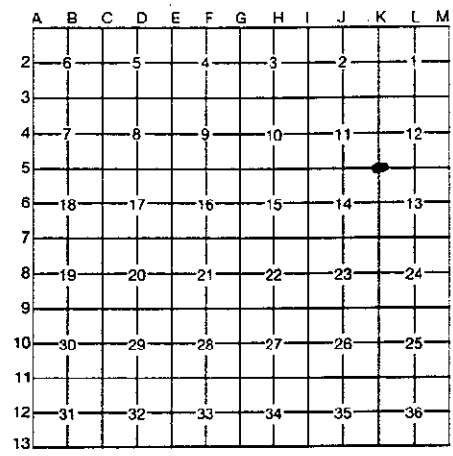

I, Robert L. James, in a field survey on September 15, 1997, 19_____, do hereby certify that under requirements of P.A. 74, Michigan P.A. of 1970, the corner points mentioned in lines 1 and 2 above were in conformance with regulations and rules therefore as required in the current manual of survey instructions of the United States Department of the Interior, Bureau of Land Management or by a decree of a Court of Law and/or that the corner points mentioned in lines 3, 4 and 5 above were in conformance with the rules of the Michigan Board of Professional Surveyors or by a Decree of a Court of Law; established, re-established, monumented, re-monumented, recovered, found as expressed below:

NOTE: Not more than 4 corners, all in the same town and range, may be recorded on this certificate.

A. Description of original monument and accessories and/or subsequent restoration:

K5: PLS - George E. Adair, SS, 1851 * Set post at corner of Sections 11, 12, 13, & 14 * Beech 6, N.46 W., 55 links * Beech 10, S.34 E., 23 links ***** R.J. Brotherton, RLS, C.C.I.Co., 1949 * Set 5/8 inch by 8 inch bolt and 4 inch pine stake from original Beech BT, N.46 W., 55 links * Wit., Maple 7, N.18 1/2 W., 35 links * Sugar 9, S.33 E., 42 links * Unrecorded ***** Robert E. Schmeling, RLS, 1980 * Recovered 8 inch bolt and BT's of R.J. Brotherton, 1949 * Replaced bolt with 1 inch iron pipe w/brass cap * Placed locator tag on Red Maple 6, 6 feet Southeast * Wit., R. Maple 12, N.17 W., 27.8 feet * Y. Birch 13, N.43 E., 27.7 feet * Hemlock 13, S.80 E., 48.7 feet * Beech 17, N.83 W., 22.9 feet * Recorded in L.1, P.380, Alger Co. corner records. ***** No other subsequent restoration on record.

B. Description of corner evidence found and/or method applied in restoring or reestablishing corner:

K5: Found 1 inch galv. iron pipe w/brass cap partially destroyed and unearthed, brass cap gone * Also found 8 inch bolt * R. Maple 6, w/ locator tag dead and down * Recovered existing BT's * Reset corner position from existing BT's and 8 inch bolt * Monument as reset is accepted as a careful and faithful perpetuation of the position of the original corner.

C. Description of monument for corner and accessories established to perpetuate locating the position of the corner:

K5: Set Berntsen Monument No. A1NB30, stamped to identify corner position * Renewed existing BT's w/BT signs and paint * PK w/ Alum. I.D. washers for measure in the following * Exist. BT, Maple 18, N.15 W., 23.74 feet, "Obl Blzd" * Exist. BT, Sugar 12, S.27 E., 27.7 feet, "Obl Blzd", no signs * Exist. BT, Y. Birch 20, N.44 E., 26.96 feet * Exist. BT, Hemlock 22, S.76 E., 48.88 feet * Exist. BT, Beech 24, N.83 W., 22.52 feet * Survey marker sign on 6-foot steel post, S.22 W., 2.0 feet * All bearings are magnetic.

Signed by Robert L. James
Surveyor's Michigan License No. 25849

Date 12/10/1997

