

DEC 27 1999

Approved by Alger County
Land Survey Remonumentation
Peer Group Under Act 345 of
P.A. of 1990 On 12-8-99

Donald W. Kinnunen
Chairman

For corners in SECTION

LAND CORNER RECORDATION CERTIFICATE
Filing Requirement of Act 74, Mich. P.A. 1970

05-177

Alger (County)	Located In:	Corner Code #
1. Public Land Survey	T 48N R 15W	M2 ✓
	T 48N R 14W	AZ
	T _____ R _____	_____
	T _____ R _____	_____
2. Property Controlling in Section	S _____ T _____ R _____	_____
	S _____ T _____ R _____	_____
3. Miscellaneous Property in Section	S _____ T _____ R _____	_____
	S _____ T _____ R _____	_____

FILED
TIME 1:30 pm

DEC 15 1999

DONALD W. KINNUNEN
REGISTER OF DEEDS
ALGER COUNTY, MI
Register of Deeds Stamp & File Number

4. Lot No. _____, Recorded Plat _____
5. Private Claims _____

	A	B	C	D	E	F	G	H	I	J	K	L	M
2	6		5		4		3		2				
3													
4	7		8		9		10		11		12		
5													
6	18		17		16		15		14		13		
7													
8	19		20		21		22		23		24		
9													
10	30		29		28		27		26		25		
11													
12	31		32		33		34		35		36		
13													

I, Robert L. Jamros, in a field survey on October 20, 1999, 19 _____ do hereby state that under requirements of P.A. 74, Michigan P.A. of 1970, the corner points mentioned in lines 1 and 2 above were in conformance with regulations and rules therefore as required in the current manual of survey instructions of the United States Department of the Interior, Bureau of Land Management or by a decree of a Court of Law and/or that the corner points mentioned in lines 3, 4 and 5 above were in conformance with the rules of the Michigan Board of Land Surveyors or by a Decree of a Court of Law; established, re-established, monumented, recovered, found as expressed below:

NOTE: Not more than 2 corners, all in the same town and range, may be recorded on this certificate.

A. Description of original monument and accessories and/or subsequent restoration:


M2: PLS * William A. Burt, DS, 1841. * Set quarter section post. * Beech 11", S.63 W., 36 links. * Beech 10", N.41 E., 25 links. **** C.C.I. Co., Land Corner Record. * T.J. McLaren, 1967. * Set post on corrected line, 40.0 chains North of established section corner. * Sugar 9", S.67 W., 16.3 feet. * Sugar 8", N.74 E., 19.8 feet. * Unrecorded. **** Robert E. Schmeling, RLS, 1980. * Found no evidence of original bearing trees. * Found stake point and 2 BT's of the 1967 unrecorded report. * Set 1" iron pipe with brass cap at stake point location with reference to existing BT's. * H.Maple 8", N.14 W., 32.7 feet (1/4 S1 NBT). * H.Maple 11", S.30 E., 27.3 feet (1/4 S6 NBT). * Y.Birch 9", S.71 W., 25.4 feet (1/4 S1 NBT). * Liber 1, Page 355, Alger County Corner Records. **** No other subsequent restoration of record.

B. Description of corner evidence found and/or method applied in restoring or reestablishing corner:

M2: Located corner search area by calculated position and standard field survey methods. Found 1" iron pipe with brass cap and 3 references of the 1980 report. Also found 2 references of the 1967 unrecorded report. Existing monument and all references are in good condition. Existing corner monument as found lies 1.6 feet west of line and 10.8 feet south of proportional position between section corners 1/2 mile north and 1/2 mile south. Renewed existing references. Existing monument as found is accepted as the best available evidence of the position of the original corner.

C. Description of monument for corner and accessories established to perpetuate locating the position of the corner:

M2: Existing 1" iron pipe with brass cap. * Renewed existing references with BT signs and paint. Set PK nails with aluminum I.D. washers for measure in the following: Existing - Y.Birch 12", S.74 W., 25.31 feet. * Maple 18", N.11 W., 32.40 feet. * Maple 16", S.29 E., 27.37 feet. * Maple 16", N.73 E., 19.82 feet. * Survey marker sign on 6 foot steel post, S.63 E., 1.5 feet. * All bearings are magnetic.

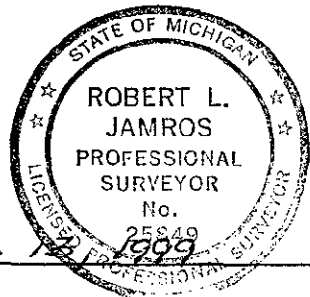

Signed by Robert L. Jamros
Surveyor's Michigan License No. 25849

Date Dec 15 1999