

Approved by Alger County
Land Survey Remonumentation
Peer Group Under Act 345 of
P.A. of 1990 On 3-24-1997

Harold Carlson
Chairman

LAND CORNER RECORDATION CERTIFICATE
Filing Requirement of Act 74, Mich. P.A. 1970

5-12

For corners in

ALGER
(County)

Located In:

Corner Code #

- | | | | | | |
|---|---|------------|---|------------|------------|
| 1. Public Land Survey | T | <u>48N</u> | R | <u>16W</u> | <u>E11</u> |
| | T | _____ | R | _____ | _____ |
| | T | _____ | R | _____ | _____ |
| | T | _____ | R | _____ | _____ |
| 2. Property Controlling
in Section | S | _____ | T | _____ | R |
| | S | _____ | T | _____ | R |
| 3. Miscellaneous
Property in Section | S | _____ | T | _____ | R |
| | S | _____ | T | _____ | R |

FILED
TIME 2:00 pm

MAR 31 1997

DONALD W. KINNUNEN
REGISTER OF DEEDS
ALGER COUNTY, MI

Register of Deeds Stamp & File Number

4. Lot No. _____, Recorded Plat _____
5. Private Claims _____

I, Robert L. Jamros, in a field survey on November 01, 1996, 19_____, do hereby certify that under requirements of P.A. 74, Michigan P.A. of 1970, the corner points mentioned in lines 1 and 2 above were in conformance with regulations and rules therefore as required in the current manual of survey instructions of the United States Department of the Interior, Bureau of Land Management or by a decree of a Court of Law and/or that the corner points mentioned in lines 3, 4 and 5 above were in conformance with the rules of the Michigan Board of Professional Surveyors or by a Decree of a Court of Law; established, re-established, monumented, re-monumented, recovered, found as expressed below:

NOTE: Not more than 4 corners, all in the same town and range, may be recorded on this certificate.

	A	B	C	D	E	F	G	H	I	J	K	L	M
2	6		5		4		3		2		1		
3													
4	7		8		9		10		11		12		
5													
6	18		17		16		15		14		13		
7													
8	19		20		21		22		23		24		
9													
10	30		29		28		27		26		25		
11													
12	31		32		33		34		35		36		
13													

A. Description of original monument and accessories and/or subsequent restoration:

E11: PLS - William Ives, DS, 1850, Post set corner of Sections 28-29-32 & 33 * Beech 6, N.45 W., 20 links * Beech 10, S.67 E., 24 links * Harold C. Lawrence, RLS, No date, but prior to 1947 * Set squared, scribed 6' post. * C.C.I.Co. Records. * Ray J. Brotherton, RLS, 1947 * Set steel truck spring leaf for monument alongside of H.C. Lawrence squared, scribed 6' post * No references. * C.C.I.Co. Records. * Ray J. Brotherton, RLS, 1952 * Recovered truck spring leaf, added Bearing Trees and replaced the down post this trip * 17' Sugar, N.23 E., 5 Links * 16' Y.Birch, S.50 E., 20.5 Links * C.C.I.Co. Records. * C.C.I.Co., Forestry Division, 1953, Author Unknown * Set scribed 6' Fir post. Gov't. BT stub here, N.45W., 20 Links and Beech stump remains, S.67 E., 24 Links * Witness * Beech 11, NBT, N.70 1/4 E., 19.0 feet * Sugar 8, NBT, S.28 1/2 W., 36.0 feet * No other subsequent restoration.

B. Description of corner evidence found and/or method applied in restoring or reestablishing corner:

E11: Found down and decayed 6' Fir post and remains of post point in post hole, steel truck spring leaf missing. Corner position lies on the edge of a well graded track road with berms of dirt on either side. By all appearances the corner monument was graded out during a logging contract in the area. Also found four existing NBT's. The two NBT's of the 1952 report have been destroyed. * Set new monument at corner position in place of post point which checks well with two existing BT's of the 1953 report * New monument as set at corner position is accepted as a careful and faithful perpetuation of the position of the original corner.

**SURVEY &
REMONUMENTATION**

AUG 15 1997


COMMISSION

C. Description of monument for corner and accessories established to perpetuate locating the position of the corner:

E11: Set Berntsen Mon. No. A1N830, Stamped to identify corner position. Renewed existing reference trees w/ BT signs and paint. Established additional reference tree w/ BT sign, blazed, scribed and painted. Set PK nails for measure w/ Alum. I.D. washers in the following reference trees. * Ex. BT, Beech 16", N.76 E., 19.05 feet, Upper and lower blazes * Ex. BT, Sugar 12", S.33 1/2 W., 36.00 feet, stump * Ex. BT, Maple 8", S.73 E., 10.45 feet, Upper and lower blazes w/ measuring notch * Ex. BT, Maple 6", N.83 1/2 W., 8.44 feet, Upper and lower blazes w/ measuring notch * New BT, Maple 7", S.36 1/2 W., 21.84 feet, scribed "S32 BT". * Survey marker sign on six foot steel post, N.51 E., 1.0 feet. * All bearings are magnetic.

Signed by

Robert L. Jamros
Surveyor's Michigan License No. 25849

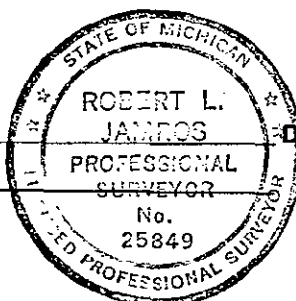

Date 25 March 1997

FORM APPROVED BY MICHIGAN STATE BOARD OF PROFESSIONAL SURVEYORS, JAN. 25, 1971
REVISED MAY 14, 1975
REVISED JAN., 1983