

Approved by Alger County
Land Survey Remonumentation
Peer Group Under Act 345 of
P.A. of 1990 On 3-24-1997

Donald Carlson
Chairman

LAND CORNER RECORDATION CERTIFICATE
Filing Requirement of Act 74, Mich. P.A. 1970.

5-10

For corners in
ALGER - SCHOOLCRAFT Located In: Corner Code #
(County)

- 1. Public Land Survey T 48N R 16W E13
T 47N R 16W E1
T _____
T _____
- 2. Property Controlling S _____ T _____ R _____
in Section S _____ T _____ R _____
- 3. Miscellaneous S _____ T _____ R _____
Property in Section S _____ T _____ R _____

FILED
TIME 2:00 p.m.

MAR 31 1997

DONALD W. KINNUNEN
REGISTER OF DEEDS
ALGER COUNTY, MI
Register of Deeds Stamp & File Number

- 4. Lot No. _____, Recorded Plat _____
- 5. Private Claims _____

I, Robert L. Jamros, in a field survey on July 09, 1996, 19_____, do hereby certify that under requirements of P.A. 74, Michigan P.A. of 1970, the corner points mentioned in lines 1 and 2 above were in conformance with regulations and rules therefore as required in the current manual of survey instructions of the United States Department of the Interior, Bureau of Land Management or by a decree of a Court of Law and/or that the corner points mentioned in lines 3, 4 and 5 above were in conformance with the rules of the Michigan Board of Professional Surveyors or by a Decree of a Court of Law; established, re-established, monumented, re-monumented, recovered, found as expressed below:

	A	B	C	D	E	F	G	H	I	J	K	L	M
2	6		5		4		3		2		1		
3													
4	7		8		9		10		11		12		
5													
6	18		17		16		15		14		13		
7													
8	19		20		21		22		23		24		
9													
10	30		29		28		27		26		25		
11													
12	31		32		33		34		35		36		
13													

T.47N. R.16W. E1 Schoolcraft Co.

NOTE: Not more than 4 corners, all in the same town and range, may be recorded on this certificate.

A. Description of original monument and accessories and/or subsequent restoration:

E13: PLS - William A. Burt, DS, 1841, Set post corner of Sections 32 & 33 * Birch 30, N.50 E., 25 links * Birch 9, N.70 W., 26 links * W.Pine 40, S.47 E., 15 links * W.pine 36, S.76 W., 34 links **** C.C.I.Co., Forestry division. * Timber cruise sheets years past indicate corner position as a Harold C. Lawrence, RLS, post and Y. Birch BT **** C.C.I.Co., Corner records, G.Moote, 1963. * Located while cruising in 1959, Y.Birch stub BT here - post set from BT's **** No other subsequent restoration.

B. Description of corner evidence found and/or method applied in restoring or reestablishing corner:

E13: Found remains of old post point 8' below ground surface. Located original GLO reference tree locations. W.Pine 36'(now stump), S.76 W, 34 links, scribing and notch visible. W.pine 40'(now stump), S.47 E., 15 links. Birch 9'(decayed stump) N.70 W., 26 links. Set new monument in post point hole. Monument as set is accepted as a careful and faithful perpetuation of the position of the original corner.

SURVEY & REMONUMENTATION


AUG 15 1997

COMMISSION

C. Description of monument for corner and accessories established to perpetuate locating the position of the corner:

E13: Set Berntsen Monument No. A1NB30, stamped to identify corner position. Established reference trees w/ BT signs, blazed, scribed and painted. Set PK nails for measure w/ Alum. I.D. washers in the following reference trees. * Maple 12", N.14 E., 9.33 feet, "S33 BT" * Maple 14", N.54 W., 19.08 feet, "S32 BT" * Maple 8", S.70 W., 8.87 feet, "S5 BT" * Beech 4", S.19 E., 5.17 feet. * Survey marker sign on six foot steel post, N.63 E., 1.05 feet. * All bearings are magnetic.

Signed by Robert L. Jamros
Surveyor's Michigan License No. 25849

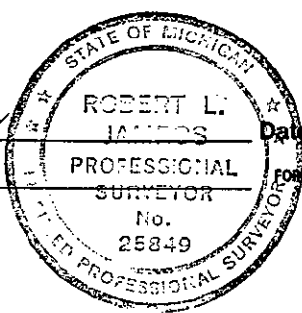

Date 25 March, 1997

FORM APPROVED BY MICHIGAN STATE BOARD OF PROFESSIONAL SURVEYORS, JAN. 28, 1971
REVISED MAY 14, 1975
REVISED JAN, 1983