

Approved by Alger County
 Land Survey Commission
 Peer Group Under Article 17
 P.A. of 1980 On 3-24-97

Harold Carlson
 Chairman

LAND CORNER RECORDATION CERTIFICATE
Filing Requirement of Act 74, Mich. P.A. 1970

5-13

For corners in ALGER (County) Located In: Corner Code #

1. Public Land Survey	T	<u>48N</u>	R	<u>16W</u>	<u>G12</u>
	T		R		
	T		R		
	T		R		
2. Property Controlling in Section	S		T		R
	S		T		R
3. Miscellaneous Property in Section	S		T		R
	S		T		R

4. Lot No. _____, Recorded Plat _____

5. Private Claims _____

FILED
 TIME 2:00 pm
MAR 31 1997
 DONALD W. KINNUNEN
 REGISTER OF DEEDS
 ALGER COUNTY, MI
 Register of Deeds Stamp & File Number

I, Robert L. Jamros, in a field survey on November 01, 1996, 19____, do hereby certify that under requirements of P.A. 74, Michigan P.A. of 1970, the corner points mentioned in lines 1 and 2 above were in conformance with regulations and rules therefore as required in the current manual of survey instructions of the United States Department of the Interior, Bureau of Land Management or by a decree of a Court of Law and/or that the corner points mentioned in lines 3, 4 and 5 above were in conformance with the rules of the Michigan Board of Professional Surveyors or by a Decree of a Court of Law; established, re-established, monumented, re-monumented, recovered, found as expressed below:

A	B	C	D	E	F	G	H	I	J	K	L	M
2	6		5		4		3		2		1	
3												
4	7		8		9		10		11		12	
5												
6	18		17		16		15		14		13	
7												
8	19		20		21		22		23		24	
9												
10	30		29		28		27		26		25	
11												
12	31		32		33		34		35		36	
13												

NOTE: Not more than 4 corners, all in the same town and range, may be recorded on this certificate.

A. Description of original monument and accessories and/or subsequent restoration:

G12: PLS - William Ives, DS, 1850, Set quarter Section post * Sugar 5, N.45 W., 5 links * Y. Birch 30, S.60 E., 11 links **** No other subsequent restoration found.

**SURVEY &
 REMONUMENTATION**
AUG 15 1997
COMMISSION


B. Description of corner evidence found and/or method applied in restoring or reestablishing corner:

G12: Located corner position at intersection of North - South and East - West paint lines. Found 3" steel truck leaf spring protruding 2" above ground level. Ray J. Brotherton, RLS, C.C.I.Co., monumented other corners in this area with a steel truck leaf spring. Therefore the truck leaf spring at this corner position was accepted as a monument set by Ray J. Brotherton. At GLO BT position, Sugar 5, N.45 W., 5 links, found a 20" Maple stub, center rotted out. Direction and distance from leaf spring was measured, N.46 W., 4.55 links. At GLO BT position, Y. Birch 30, S.60 E., 11 links, found stump hole identified as Y. Birch. Direction and distance from leaf spring to stump hole is within acceptable limits. Set new monument adjacent to existing leaf spring. Monument as set at corner position is accepted as a careful and faithful perpetuation of the position of the original corner.

C. Description of monument for corner and accessories established to perpetuate locating the position of the corner:

G12: Set Berntsen Monument No. A1N830, stamped to identify corner position. Established reference trees w/ BT signs, blazed, scribed and painted. Set PK nails for measure w/ Alum. I.D. washers in the following reference trees. * Maple 7", S.69 W., 8.03 feet, "1/4S BT" * Maple 5", N.14 W., 11.27 feet, "1/4S BT" * Beech 5", S.26 E., 40.66 feet, "1/4S BT" * Beech 3", N.50 E., 4.21 feet, "1/4S BT", not scribed. * Survey marker sign on six foot steel post, N.73 W., 1.0 feet. * All bearings are magnetic.

Signed by Robert L. Jamros
 Surveyor's Michigan License No. 25849

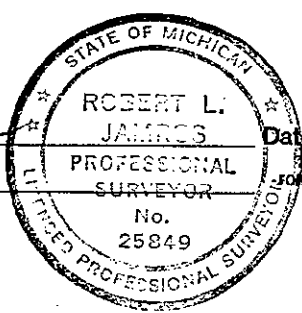

Date 25 March, 1997