

Approved by Alger County
Land Survey Remonumentation
Peer Group Under Act 345 of
P.A. of 1990 On 3-24-1997

Harold Carlson
Chairman

LAND CORNER RECORDATION CERTIFICATE
Filing Requirement of Act 74, Mich. P.A. 1970

5-11

For corners in
ALGER - SCHOOLCRAFT
(County)

Located In:

Corner Code #

- | | | | | | |
|--------------------------------------|---|------------|---|------------|------------|
| 1. Public Land Survey | T | <u>48N</u> | R | <u>16W</u> | <u>G13</u> |
| | T | <u>47N</u> | R | <u>16W</u> | <u>G1</u> |
| | T | _____ | R | _____ | _____ |
| | T | _____ | R | _____ | _____ |
| 2. Property Controlling in Section | S | _____ | T | _____ | R |
| | S | _____ | T | _____ | R |
| 3. Miscellaneous Property in Section | S | _____ | T | _____ | R |
| | S | _____ | T | _____ | R |


FILED
TIME 2:00 pm.

MAR 31 1997

DONALD W. KINNUNEN
REGISTER OF DEEDS
ALGER COUNTY, MI

Register of Deeds Stamp & File Number

4. Lot No. _____, Recorded Plat _____
5. Private Claims _____

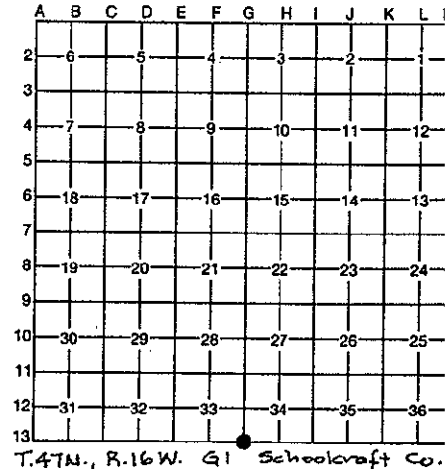

I, Robert L. Jamros, in a field survey on November 01, 1996, 19_____, do hereby certify that under requirements of P.A. 74, Michigan P.A. of 1970, the corner points mentioned in lines 1 and 2 above were in conformance with regulations and rules therefore as required in the current manual of survey instructions of the United States Department of the Interior, Bureau of Land Management or by a decree of a Court of Law and/or that the corner points mentioned in lines 3, 4 and 5 above were in conformance with the rules of the Michigan Board of Professional Surveyors or by a Decree of a Court of Law; established, re-established, monumented, re-monumented, recovered, found as expressed below:

NOTE: Not more than 4 corners, all in the same town and range, may be recorded on this certificate.

A. Description of original monument and accessories and/or subsequent restoration:

G13: PLS - William A. Burt, DS, 1841, Set post corner of Sections 33 & 34 * Beech 12, N.72 E., 55 links * Beech 20, N.23 W., 57 links **** C.C.I.Co., Forestry Division, Ray J. Brotherton, RLS, 1947. * Steel truck spring leaf set for monument. Harold C. Lawrence, RLS, scribed post also. Spring leaf set 6-22-47. Scribed NBT's. * Sugar 17, N.23 E., 5 links * Y. Birch 16, S.50 E., 20 1/2 links * No other subsequent restoration found.

B. Description of corner evidence found and/or method applied in restoring or reestablishing corner:

G13: Found steel truck spring leaf at corner position. No evidence of Harold C. Lawrence scribed post remains. Search was made at both GLO BT positions for remains of evidence. At the N.72 E. and the N.23 W. positions found stump holes w/ dark soil and small amounts of decayed wood, inconclusive. From the steel truck spring leaf the NBT's of the 1947 report are as follows. The Sugar 17, N.23 E., 5 links (3.30 feet) is now a stump hole with small amounts of decayed wood. The Y. Birch 16, S.50 E., 20 1/2 links (13.53 feet) (M= 15.51 feet) is now a half alive stub w/ marks visible and old blazes around peripheral of stub. Set new monument adjacent to steel truck spring leaf. Monument as set at corner position is accepted as a careful and faithful perpetuation of the position of the original corner.

SURVEY & REMONUMENTATION

AUG 15 1997


COMMISSION

C. Description of monument for corner and accessories established to perpetuate locating the position of the corner:

G13: Set Berntsen Monument No. A1NB30 adjacent to spring leaf, stamped to identify corner position. Renewed existing reference trees w/ BT signs and paint. Established additional reference trees w/ BT signs, blazed, scribed and painted. Set PK nails for measure w/ Alum. I.D. washers in the following reference trees. * Exist. BT, Beech 16", S.10 E., 16.52 feet, Scribed "BT" and existing blazes. * Maple 9", N.68 E., 28.64 feet, "S34 BT" * Maple 6", N.46 W., 30.92 feet, "S33 BT" * Maple 5", S.78 W., 28.00 feet, "S4 BT" * Survey marker sign on six foot steel post, N.55 E., 1.0 feet. * All bearings are magnetic.

Signed by Robert L. Jamros

Surveyor's Michigan License No. 25849

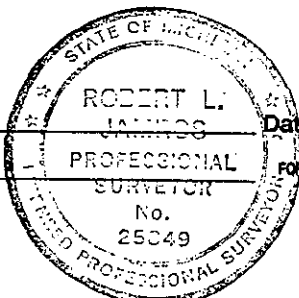

Date 25 March, 1997