

**LAND CORNER RECORDATION CERTIFICATE**  
**Filing Requirement of Act 74, Mich. P.A. 1970 as Amended**

For corners in

<u>Alger</u> (County)	Located In:	Corner Code #
1. Public Land Survey	T 48N R 16W	M3
	T 48N R 16W	K2
	T _____ R _____	_____
2. Property Controlling in Section	S _____ T _____ R _____	_____
	S _____ T _____ R _____	_____
	S _____ T _____ R _____	_____
3. Miscellaneous Property in Sec.	S _____ T _____ R _____	_____
	S _____ T _____ R _____	_____

4. Lot No. \_\_\_\_\_, Recorded Plat \_\_\_\_\_  
 5. Private Claims \_\_\_\_\_

M3 09/09/2008  
 K2 11/03/2008

I, Stephan J. Szyszkoski, in a field survey on \_\_\_\_\_ do hereby state that under requirements of P.A. 74, Michigan P.A. of 1970, the corner points mentioned in lines 1 and 2 above were in conformance with regulations and rules therefore as required in the current manual of survey instructions of the United States Department of the Interior, Bureau of Land Management or by a decree of a Court of Law and /or that the corner points mentioned in lines 3, 4 and 5 above were in conformance with the rules of the Michigan Board of Land Surveyors or by a Decree of a Court of Law; established, re-established, monumented, recovered, found as expressed below:

**NOTE: Not more than 2 corners, all in the same town and range, may be recorded on this certificate.**

Register of Deeds Stamp & File Number

	A	B	C	D	E	F	G	H	I	J	K	L	M
1													
2	6		5		4		3		2		1		
3													
4	7		8		9		10		11		12		
5													
6	18		17		16		15		14		13		
7													
8	19		20		21		22		23		24		
9													
10	30		29		28		27		26		25		
11													
12	31		32		33		34		35		36		
13													

**A. Description of original monument and accessories and/or subsequent restoration:**

(M3) Corner common to Sections 1-12 T48N-R16W and Sections 6-7 T48N-R15W. 1960 - Corner perpetuated by Billy D. Buckler RLS: This corner was replaced at wood post set by R.J. Brotherton, Registered Surveyor. Found Y.Pine stump bottom bearing N69E 11 links. Set 1" pipe with 4" brass cap. 30" W.Pine stub N61W 110 links, 28" W.Pine stump S29W 103 links, 24" W.Pine stump S19E 94 links.

(K2) Quarter corner common to Sections 1 and 2. 1948 - Reestablished by Ray J. Brotherton, RLS, proportionate to the original record distance between Section corners K1 and K3 north and south and on a line between K1 and a Gov't Hemlock Line tree stub south of K1. Set 4" post and an iron on east side of G.T. Corp log road. No witnesses made. Gov't BTs are all in road area and missing.

**B. Description of corner evidence found and/or method applied in restoring or reestablishing corner:**

(M3) Found the 1960 monument of record in good condition and at record bearing and distance from the 1960 witnesses, all in place. The Y.Pine stump bottom N69E was not recovered. Accepted the monument as a careful and faithful perpetuation of the position of the original corner.

(K2) Found a 3" wide leaf spring, set firm and plumb, in good condition. From the GLO record position for the corner (by single proportionate measurement and on line between Section corners K1 and K3 north and south) the leaf spring is 3.6' North and 6.5' East. I accept the leaf spring as the Brotherton monument of 1948 and as a careful and faithful reestablishment of the position of the original corner. Placed a new monument, described below, at the position of the leaf spring.

**C. Description of monument for corner and accessories established to perpetuate locating the position of the corner:**


(M3) Fd. 1" ID I. pipe with 4" brass MI Dept. of Conservation cap. Set measuring nail with MDNR tag in the side of:  
 10" R.Pine N46W 40.9' mrkd "S1 NBT"  
 8" Spruce N25E 25.79' "S6 NBT"  
 6" Spruce N75E 19.21' "S6 NBT"  
 6" Spruce clump S41W 2.13' "S12 NBT"  
 Bearings are magnetic.

(K2) Set 5/8"x24" rebar with plastic cap "MI DNR LS33986". Set measuring nail with MDNR tag in the side of:  
 11" Maple S87W 31.82' mrkd "1/4S NBT"  
 8" Maple S02W 5.98' do  
 7" Maple N85E 13.19' do  
 6" Maple N34E 12.81' do  
 Bearings are magnetic. Centerline of a trail is 12' west.

Signed by Stephan J. Szyszkoski  
 Surveyor's Michigan License No. 33986

Date 05/07/2009

For the Michigan Department of Natural Resources, Office of Land and Facilities

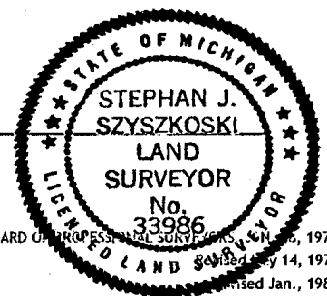

47217  
 47218