

DEC 27 1999

Approved by Alger County
Land Survey Remonumentation
Peer Group Under Act 345 of
P.A. of 1990 On 12-8-1999

Donald W. Kinnunen
Chairman

For corners in SECTION

LAND CORNER RECORDATION CERTIFICATE
Filing Requirement of Act 74, Mich. P.A. 1970

Alger (County)	Located In:	Corner Code #
1. Public Land Survey	T 48N R 15W	M3
	T 48N R 14W	A3 ✓
	T _____ R _____	_____
	T _____ R _____	_____
2. Property Controlling in Section	S _____ T _____ R _____	_____
	S _____ T _____ R _____	_____
3. Miscellaneous Property in Section	S _____ T _____ R _____	_____
	S _____ T _____ R _____	_____

05-178

FILED

TIME 1:30 p.m.

DEC 15 1999

DONALD W. KINNUNEN
REGISTER OF DEEDS

Register of Deeds Stamp & File Number

4. Lot No. _____, Recorded Plat _____
5. Private Claims _____

I, Robert L. Jamros, in a field survey on September 17, 1999, 19_____
do hereby state that under requirements of P.A. 74, Michigan P.A. of 1970, the corner points mentioned
in lines 1 and 2 above were in conformance with regulations and rules therefore as required in the current
manual of survey instructions of the United States Department of the Interior, Bureau of Land
Management or by a decree of a Court of Law and/or that the corner points mentioned in lines 3, 4 and
5 above were in conformance with the rules of the Michigan Board of Land Surveyors or by a
Decree of a Court of Law; established, re-established, monumented, _____ recovered, found
as expressed below:

NOTE: Not more than 2 corners, all in the same town and range, may be recorded
on this certificate.

	A	B	C	D	E	F	G	H	I	J	K	L	M
2	6		5		4		3		2		1		
3													
4	7		8		9		10		11		12		
5													
6	18		17		16		15		14		13		
7													
8	19		20		21		22		23		24		
9													
10	30		29		28		27		26		25		
11													
12	31		32		33		34		35		36		
13													

A. Description of original monument and accessories and/or subsequent restoration:


M3: PLS * William A. Burt, DS, 1841. * Set post corner of Sections 1 and 12. * Beech 18", S.19 E., 40 links. * Beech 16", N.39 W., 51 links. * Sugar 12", S.64 W., 11 links. * Sugar 10", N.70 W., 30 links. **** C.C.I. Co, Land Corner Record. * J.R. Radcliffe, RLS, 1951. * Set post from Maple BT, down and rotted. * Chained East from line tree remains on South line of Section 1. * Found piece of facing of the BT with scribe marks "R15" and "S12", visible. * No references were documented. * Unrecorded report from C.C.I. Co. files. **** C.C.I. Co., Land Corner Records. * T.J. McLaren, 1965. * Set post by double measurement from unrecorded accessories. * Beech 6", S.60 E., 24.6 feet. * Sugar 14", N.05 W., 9.5 feet. * Unrecorded. **** Robert E. Schmeling, RLS, 1980. * Found 5" squared Cedar stake set by J.R. Radcliffe in 1951 unrecorded report. * Found 2 BT's set by T.J. McLaren in 1965 unrecorded report. * Using existing BT's, set 1" iron pipe with brass cap. * Beech 8", N.72 E., 20.9 feet (S6 NBT). * H.Maple 12", S.42 E., 53.7 feet (S7 NBT). * H.Maple 14", S.40 W., 33.1 feet (S12 NBT). * Beech 15", N.64 W., 33.6 feet (S1 NBT). * Liber 1, Page 353, Alger County Corner Records. **** No other subsequent restoration of record.

B. Description of corner evidence found and/or method applied in restoring or reestablishing corner:

M3: Located corner search area by calculated position and standard field survey methods. Found 1" iron pipe with brass cap and 4 remaining references of the 1965 unrecorded report and of the recorded 1980 report. Monument and references are in good condition. Existing corner monument as found is accepted as a careful and faithful perpetuation of the position of the original corner.

C. Description of monument for corner and accessories established to perpetuate locating the position of the corner:

M3: Existing 1" iron pipe with brass cap. * Renewed existing reference trees with BT signs and paint. * Set PK nails with aluminum I.D. washers in the following: Existing - Beech 20", N.67 W., 33.65 feet. * Existing - Beech 13", N.74 E., 20.93 feet. * Existing - Beech 16", S.63 E., 24.85 feet. * Existing - Maple 20", S.42 E., 53.57 feet. * Survey marker sign on 6 foot steel post, S.83 W., 1.5 feet. * All bearings are magnetic.

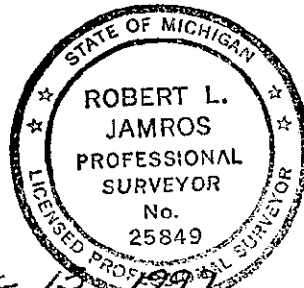

Signed by *Robert L. Jamros* Date Dec 15 1999
Surveyor's Michigan License No. 25849