

Approved by Alger County
Land Survey Re-monumentation
Pier Group Under Act 345 of
P.A. of 1990 On 3-24 1997

Gerald Carlson
Chairman

LAND CORNER RECORDATION CERTIFICATE
Filing Requirement of Act 74, Mich. P.A. 1970

5-28


For corners in ALGER Located In: _____ Corner Code # _____
(County)

- 1. Public Land Survey T 49N R 13W A5
T 49N R 14W M5
T _____ R _____
T _____ R _____
- 2. Property Controlling S _____ T _____ R _____
in Section S _____ T _____ R _____
- 3. Miscellaneous S _____ T _____ R _____
Property in Section S _____ T _____ R _____

FILED
TIME 2:00 PM
MAR 31 1997
DONALD W. KINNUNEN
REGISTER OF DEEDS
ALGER COUNTY, MI
Register of Deeds Stamp & File Number

- 4. Lot No. _____, Recorded Plat _____
- 5. Private Claims _____

I, Robert L. Jaaros, in a field survey on October 07, 1996, 19_____, do hereby certify that under requirements of P.A. 74, Michigan P.A. of 1970, the corner points mentioned in lines 1 and 2 above were in conformance with regulations and rules therefore as required in the current manual of survey instructions of the United States Department of the Interior, Bureau of Land Management or by a decree of a Court of Law and/or that the corner points mentioned in lines 3, 4 and 5 above were in conformance with the rules of the Michigan Board of Professional Surveyors or by a Decree of a Court of Law; established, re-established, monumented, re-monumented, recovered, found as expressed below:

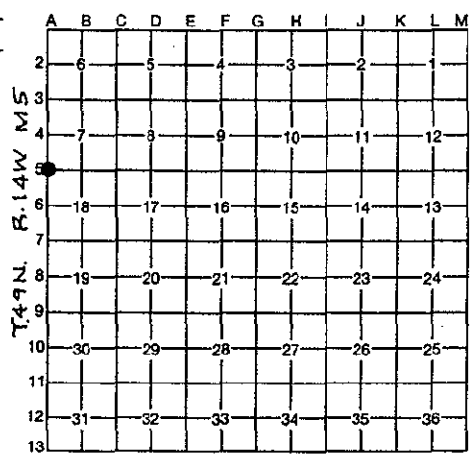


NOTE: Not more than 4 corners, all in the same town and range, may be recorded on this certificate.

A. Description of original monument and accessories and/or subsequent restoration:
A5: PLS - John Burt, DS, for William A. Burt, DS, 1841, Set post corner of Sections 12 & 13, T.49N., R.13W. * Spruce 12, S.24 W., 24 lks * Cedar 12, N.10 E., 24 lks. * Geo. E. Adair, OS, 1851. * Post, Cedar 20, N.05 W., 34 lks. * Cedar 14, S.60 E., 47 lks. **** Geo. L. Depew, CS, Dec. 1917. * Placed S.E. cor. of Sec. 12, T.49N., R.14W. * RP fen. cor. N.55 W., 49 ft. * Cor. in dit. line of M-5 road 15 ft. from center of road. **** Alger County Road Commission, Edwin Swan, R.L.S., 1949. * 1 1/4" cor. axle. * Tel. Pole, S.47 W., 37.4 ft. * Cor. fen. post, S.38 E., 39.4 ft; **** M.S.H.D., Proj. No. DS 610(3), 1958. * Sta. 768+71.45, 1 1/4" iron pipe. * P. Pole, N.22 E., 36.37 ft. * Guy Pole, N.53 W., 63.81 ft. * T. Pole, S.60 W., 48.03 ft. **** Mel Davis, RLS, 1971. * Mon. box in hwy., apparently set by the Mich. State Hwy. Dept. * Wit., USGS Bench Mark tablet in conc., N.65 W., 71.70 ft. * CL Elec. Pole, N.22 E., 35.80 ft. * CL Tele. Pole, S.61 W., 52.00 ft. * CL of State Hwy. M-77, W., 16.70 ft. * Recorded in L.1, P.4, Alger Co. Records. **** Gerald W. Carlson, RLS, 1977. * Fd. sq. top spike in mon. box E. side of M-77, CL of E-W grav. road. * Wit., P.P., N.24 E., 35.86'. * T.P., S.73 E., 81.60'. * T.P., S.63 W., 51.98'. * T.P., N.53 W., 63.47'. * Recorded in L.1, P.113, Alger Co. Records.

B. Description of corner evidence found and/or method applied in restoring or reestablishing corner:
A5: Found Boat spike in Monument box 19.6 feet East of the centerline of State Highway M-77 pavement and 3 feet South of centerline of East-West gravel road. * Replaced Boat spike w/ 5/8" X 18' Rebar w/ 3 1/4" Aluminum Cap stamped to identify corner position. Renewed existing references and objects. Monument at existing corner position is accepted as the best available evidence of the position of the original corner.

C. Description of monument for corner and accessories established to perpetuate locating the position of the corner:
A5: Set 5/8" X 18" Rebar w/ 3 1/4" Aluminum Cap stamped to identify corner position. * Corner position lies within the improved area of the Village of Grand Marais and along the M-77 corridor. * Used only PKnails for measure w/ Alum. I.D. washers in the following reference objects. * Maple 14", S.72 W., 91.97 feet. * Service Pole, N.50 W., 63.53 feet. * Transformer Pole, N.25 E., 35.78 feet. * Power Pole w/ Underground, S.64 E., 81.65 feet. * All bearings are magnetic.

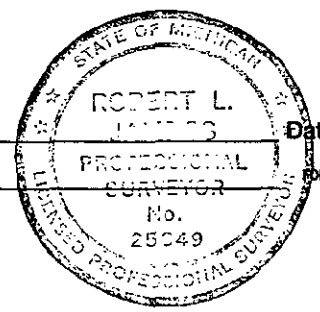Signed by Robert L. Jaaros Date 25 March, 1997
Surveyor's Michigan License No. 25849

FORM APPROVED BY MICHIGAN STATE BOARD OF PROFESSIONAL SURVEYORS, JAN. 28, 1971
REVISED MAY 14, 1975
REVISED JAN., 1983