

Approved by Alger County
Land Survey Remonumentation
Peer Group Under Act 345 of
P.A. of 1990 On 12-12-1995

SUPPLY &
COLLATERATION

JAN 23 1996

COMMISSION

4-317

Merrill W. Carlson
Chairman

LAND CORNER RECORDATION CERTIFICATE
Filing Requirement of Act 74, Mich. P.A. 1970

For corners in Alger Located In: Corner Code #
(County)

- | | | | | | |
|--------------------------------------|---|------------|---|------------|----|
| 1. Public Land Survey | T | <u>49N</u> | R | <u>13W</u> | B3 |
| | T | | R | | |
| | T | | R | | |
| | T | | R | | |
| 2. Property Controlling in Section | S | | T | | R |
| | S | | T | | R |
| 3. Miscellaneous Property in Section | S | | T | | R |
| | S | | T | | R |

REC'D and FILED

DEC 20 1995

2:45 p.m.

DONALD W. KINNUNEN, County Clerk
ALGER COUNTY, MI
Register of Deeds Stamp & File Number

4. Lot No. _____, Recorded Plat _____
5. Private Claims _____

A	B	C	D	E	F	G	H	I	J	K	L
2	6		5		4		3		2		1
3	●										
4	7		8		9		10		11		12
5											
6	18		17		16		15		14		13
7											
8	19		20		21		22		23		24
9											
10	30		29		28		27		26		25
11											
12	31		32		33		34		35		36
13											

I, Robert L. Jamros, in a field survey on July 13, 1995, 19_____, do hereby certify that under requirements of P.A. 74, Michigan P.A. of 1970, the corner points mentioned in lines 1 and 2 above were in conformance with regulations and rules therefore as required in the current manual of survey instructions of the United States Department of the Interior, Bureau of Land Management or by a decree of a Court of Law and/or that the corner points mentioned in lines 3, 4 and 5 above were in conformance with the rules of the Michigan Board of Professional Surveyors or by a Decree of a Court of Law; established, re-established, monumented, re-monumented, recovered, found as expressed below:

NOTE: Not more than 4 corners, all in the same town and range, may be recorded on this certificate.

A. Description of original monument and accessories and/or subsequent restoration:

B3: PLS-Francis Coleman, DS, 1851, Set Qr. Section Post- Sugar 10", N.69 E., 19 links, Beech 12", S.50 W., 14 links. James Roundtree, County Surveyor, 1908, Set iron stake 1 1/8" in Dia. two feet long, according to field notes and bearing trees, beside of 6" cedar post. Mel Davis, RLS, 1971, Found iron with brass cap. References: Steel fence post, NORTH, 33.0', Maple 4", S.50 E., 87.20', Filing No. 2, Alger county records.


B. Description of corner evidence found and/or method applied in restoring or reestablishing corner:

B3: Found corner monument destroyed as notified by local resident Richard Birnie by letter. Established corner position by standard survey applying local property irons and previous L.C.R.C. witnesses and other collateral evidence. Corner position lies seven feet south of centerline of East-West road. Corner position is accepted as a careful and faithful reestablishment of the position of the original corner.

C. Description of monument for corner and accessories established to perpetuate locating the position of the corner:

B3: Set 5/8" x 18" rebar w/ Berntsen Cap no. RBD5325 stamped to identify corner position. Established the following reference trees w/ BT signs, blazed, scribed and painted. Set PK nails for measure w/ Alum. I.D. washers in the following reference trees. Maple 6", S.80 W., 68.66 feet, " 1/4s BT ", W.Birch 4", N.09 W., 24.36 feet, " 1/4s BT ", Twin Maple 8", N.55 E., 43.63 feet, " 1/4s BT ", Cherry 4", S.45 E., 21.94 feet, " 1/4s BT ". All bearings are magnetic.

Signed by Robert L. Jamros
Surveyor's Michigan License No. 25849

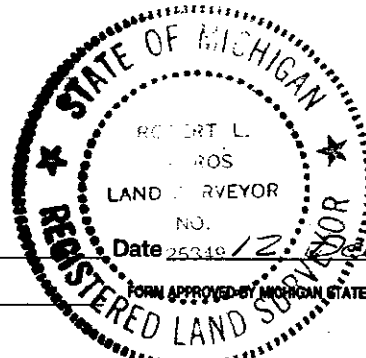

Date 25349 12 December 1995