

Approved by Alger County
 Land Survey Monumentation
 Peer Group Under Act 345 of
 P.A. of 1990 On 3-22 1997

Herald W. Carlson
 Chairman

LAND CORNER RECORDATION CERTIFICATE
 Filing Requirement of Act 74, Mich. P.A. 1970

5-30


For corners in ALGER Located In: _____ Corner Code # _____
 (County)

1. Public Land Survey	T	<u>49N</u>	R	<u>13W</u>	<u>C3</u>
	T	_____	R	_____	_____
	T	_____	R	_____	_____
	T	_____	R	_____	_____
2. Property Controlling in Section	S	_____	T	_____	R
	S	_____	T	_____	R
3. Miscellaneous Property in Section	S	_____	T	_____	R
	S	_____	T	_____	R

4. Lot No. _____, Recorded Plat _____
 5. Private Claims _____

FILED
 TIME 2:00 pm.
 MAR 31 1997
 DONALD W. KINNUNEN
 REGISTER OF DEEDS
 ALGER COUNTY, MI
 Register of Deeds Stamp & File Number

I, Robert L. Jamros, in a field survey on October 07, 1996, 19____ do hereby certify that under requirements of P.A. 74, Michigan P.A. of 1970, the corner points mentioned in lines 1 and 2 above were in conformance with regulations and rules therefore as required in the current manual of survey instructions of the United States Department of the Interior, Bureau of Land Management or by a decree of a Court of Law and/or that the corner points mentioned in lines 3, 4 and 5 above were in conformance with the rules of the Michigan Board of Professional Surveyors or by a Decree of a Court of Law; established, re-established, monumented, re-monumented, recovered, found as expressed below:

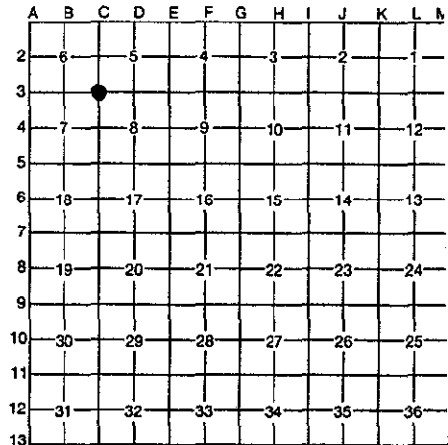


NOTE: Not more than 4 corners, all in the same town and range, may be recorded on this certificate.

A. Description of original monument and accessories and/or subsequent restoration:
 C3: PLS - Francis Colman, DS, 1851, Set post corner of Sections 5-6-7 & 8 * Beech 12, N.22 W., 27 links * Beech 14, S.61 E., 30 links ***** James Roundtree, CS, 1899. * Iron post 1 1/8" diam., 20" long driven according to field notes and Barren trees. In center of road running North & South. * References, 8" Cedar post, N.E., 69 links, corner of Paynes Fence. * 10" Cedar post, W., 38.5 links, corner of Charlie Propts fence. ***** Geo. L. Depew, CS, 1917. * Placed Standard iron corner at N.E. corner of Section 7, T.49N., R.13W. * Tele. Post, N.58 W., 22.2 feet. * Fence corner post, N.45 E. 45.4 feet. ***** Robert L. Jamros, RLS, 1978. * Found 2 1/2" pip w/ brass cap on centerline of North-South gravel road and 10 feet South of centerline of gravel road East. * Witness, Power Pole, N.40 W., 39.35 feet. * Maple 14", S.24 E., 46.40 feet. * Maple 22", S.34 W., 89.91 feet. * Recorded in L.1, P.158, Alger County Records. *****

B. Description of corner evidence found and/or method applied in restoring or reestablishing corner:
 C3: Found 2 1/2" Galvanized Iron Pipe w/ brass cap 4 inches below surface of gravel road. On centerline of North-South gravel road and 10 feet South of gravel road to the East. Renewed corner references of the 1978 report and added additional reference objects. Monument of existing corner position is accepted as a careful and faithful perpetuation of the position of the original corner.

C. Description of monument for corner and accessories established to perpetuate locating the position of the corner:
 C3: Stamped P.A. 345 in Brass capped monument. Corner position lies within the improved area of the Village of Grand Marais and along residential corridor. * Used only PK nails for measure w/ Alum. I.D. washers in the following reference objects. * Exist. BT, Maple 20", S.22 E., 46.27 feet. * Exist. BT, Maple 34", S.37 W., 89.73 feet. * Exist. BT, Power Pole, N.43 W., 39.33 feet. * Red Pine 12", N.38 E., 62.52 feet. * All bearings are magnetic.

Signed by Robert L. Jamros
 Surveyor's Michigan License No. 25849

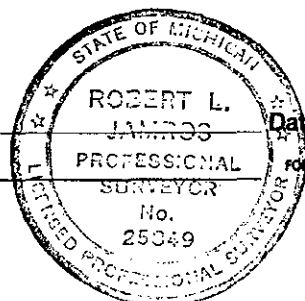

Date 25 March, 1997
 FORM APPROVED BY MICHIGAN STATE BOARD OF PROFESSIONAL SURVEYORS, JAN. 28, 1971
 REVISED MAY 14, 1975
 REVISED JAN, 1983