

Robert L. Jamros
 Chairman

LAND CORNER RECORDATION CERTIFICATE
 Filing Requirement of Act 74, Mich. P.A. 1970

4-221

For corners in
 Alger

(County)	Located In:	Corner Code #
1. Public Land Survey	T <u>49N</u> R <u>13W</u>	<u>C5</u>
	T _____ R _____	_____
	T _____ R _____	_____
	T _____ R _____	_____
2. Property Controlling in Section	S _____ T _____ R _____	_____
	S _____ T _____ R _____	_____
3. Miscellaneous Property in Sec.	S _____ T _____ R _____	_____
	S _____ T _____ R _____	_____
4. Lot No. _____, Recorded Plat _____		
5. Private Claims _____		


Recorded May 26, 1994
 at 8:00 o'clock A. M., and
 Recorded in Liber 4 of Corner Rec
 on Page 221

Alger County Register of Deeds

Register of Deeds Stamp & File Number

I, Robert L. Jamros, in a field survey on June 20, 1993, 19_____, do hereby certify that under requirements of P.A. 74, Michigan P.A. of 1970, the corner points mentioned in lines 1 and 2 above were in conformance with regulations and rules therefore as required in the current manual of survey instructions of the United States Department of the Interior, Bureau of Land Management or by a decree of a Court of Law and/or that the corner points mentioned in lines 3, 4 and 5 above were in conformance with the rules of the Michigan Board of Land Surveyors or by a Decree of a Court of Law; established, re-established, monumented, re-monumented, recovered, found as expressed below:

NOTE: Not more than 4 corners, all in the same town and range, may be recorded on this certificate.

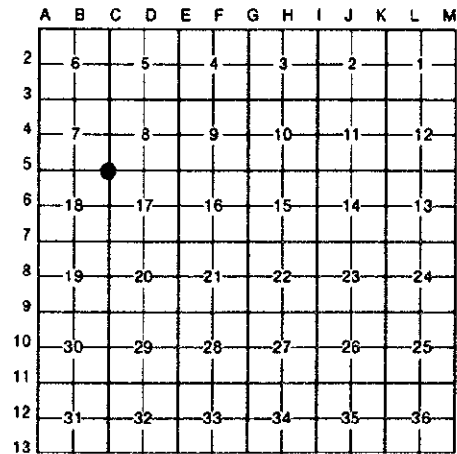

A. Description of original monument and accessories and/or subsequent restoration:

C5: P.L.S. - Francis Coleman, DS, 1851. Set post corner of Secs. 7, 8, 17 and 18. Fir 10, N.29 E., 12 links. Cedar 9, S.61 W., 64 links. James Roundtree, County Surveyor, 1908, iron driven according to field notes and barren trees. Alger County Rd. Comm., iron found during road alignment survey, 1917. Mel Davis, RLS, 1971 found 1 1/2" pipe set by persons unknown. A.C.Rec.No.6., Gerald W. Carlson, RLS, 1978, found 2" iron pipe. A.C.Rec.No.175.

B. Description of corner evidence found and/or method applied in restoring or reestablishing corner:

C5: At tee interesection of roads North, South and West found bent remains of 2" G.I.P./ with evidence of removed base plate at bottom end, top badly bent and damaged. From the turn of this century to the mid 1920's Alger County used a standard monument. Their monument was a 4 foot long, 2 inch galv. iron pipe w/a 3 1/4" brass cap and a square cast iron base plate cast to bottom. The above 2 inch G.I.P. remains resembles their monument in all ways. Located corner position with previously recorded witnesses. Installed new monument 8 inches below gravel road surface and established new references, and is accepted as a careful and faithful perpetuation of the position of the original corner. Corner lies in road inter. 4 feet South of the centerline of West road and 2 feet West of centerline of N-S road.

C. Description of monument for corner and accessories established to perpetuate locating the position of the corner:

Installed 5/8" x 18" post w/ 3/4" Alum. cap stamped to I.D. corner position. Est. reference tree w/BT signs, blazed, painted. Set PK nails for measuring w/brass I.D. washers in the following reference tree. Exist - Power pole stub, N.33 W., 49.34 ft., Exist - NGS BM A197, N.35E., 51.83 ft., Cluster of apple trees, 1 1/2" to 5", S.42 1/2 W., 65.40 ft., Not scribed. Centerline of Inter of N-S road & W. road is 2 ft., E and 4 ft. N.

Signed by Robert L. Jamros Date 2 May 1994

Surveyor's Michigan License No. 25849