

Approved by Alger County  
Land Survey Monumentation  
Peer Group Under Act 345 of  
P.A. of 1993 On 3-24-1997

Gerald Carlson  
Chairman

**LAND CORNER RECORDATION CERTIFICATE**  
Filing Requirement of Act 74, Mich. P.A. 1970

5-31

For corners in ALGER (County) Located In: Corner Code #

1. Public Land Survey	T	49N	R	13W	C6
	T		R		
	T		R		
	T		R		
2. Property Controlling in Section	S		T	R	
	S		T	R	
3. Miscellaneous Property in Section	S		T	R	
	S		T	R	

4. Lot No. \_\_\_\_\_, Recorded Plat \_\_\_\_\_

5. Private Claims \_\_\_\_\_

FILED  
TIME 2:00 p.m.

MAR 31 1997

DONALD W. KINNUNEN  
REGISTER OF DEEDS  
ALGER COUNTY, MI

Register of Deeds Stamp & File Number

I, Robert L. Jaaros, in a field survey on October 04, 1996, 19\_\_\_\_\_, do hereby certify that under requirements of P.A. 74, Michigan P.A. of 1970, the corner points mentioned in lines 1 and 2 above were in conformance with regulations and rules therefore as required in the current manual of survey instructions of the United States Department of the Interior, Bureau of Land Management or by a decree of a Court of Law and/or that the corner points mentioned in lines 3, 4 and 5 above were in conformance with the rules of the Michigan Board of Professional Surveyors or by a Decree of a Court of Law; established, re-established, monumented, re-monumented, recovered, found as expressed below:

A	B	C	D	E	F	G	H	I	J	K	L	M
2	6	5	4	3	2	1						
3												
4	7	8	9	10	11	12						
5												
6	18	17	16	15	14	13						
7												
8	19	20	21	22	23	24						
9												
10	30	29	28	27	26	25						
11												
12	31	32	33	34	35	36						
13												

NOTE: Not more than 4 corners, all in the same town and range, may be recorded on this certificate.

**A. Description of original monument and accessories and/or subsequent restoration:**

C6: PLS - Francis Colman, DS, 1851, Set quarter Section post \* Black Ash 6, N.73 E., 32 links \* Cedar 10, S.50 W., 59 links \*\*\*\* Gerald W. Carlson, RLS, 1978. \* Alger County Road Commission notes. Set iron corner. 12' Y. Birch, N.51-30 W., 36.60 feet and 8' Maple, S.86 E., 41.0 feet. \* Set 5/8" X 18" iron w/ RLS cap at centerline of North-South gravel road. Note: This corner was set in the most probable position that matched existing conditions and fences in Section 18. The distance to the Northeast Section corner, however, does not correspond with the original notes but several calls indicated substantiate this location. \* Witness, 12" Cedar, S.57 W., 44.83 feet. \* 18" Cedar, N.72 W., 44.71 feet. \* 10" W. Birch, N.47 E., 39.62 feet. \* 14" W. Birch, S.36 E., 42.57 feet. \* Recorded in L.1, P.175, Alger County Records.


**B. Description of corner evidence found and/or method applied in restoring or reestablishing corner:**

C6: Found badly bent 5/8" iron w/ RLS cap missing. Also found three reference trees from the 1978 report still green. A thorough search was made for original and subsequent evidence, found only evidence from the 1978 restoration. Occupied line and measured to Section corners South and North of this corner position. The deflection angle at this corner is approx. thirty four minutes and distance south is 39.71 chains (GLO 40 ch.) and distance North is 37.70 chains (GLO 40 ch.). Set new monument at this corner position. Corner position as found is accepted as a careful and faithful reestablishment of the position of the original corner.

**C. Description of monument for corner and accessories established to perpetuate locating the position of the corner:**

C6: Set 5/8" X 18" Rebar with Berntsen 3 1/4" aluminum cap no. R805325, stamped to identify corner position. Renewed existing reference trees w/ BT signs and paint. Established additional reference tree w/ BT signs, blazed, scribed and painted. Set PK nails for measure w/ Alum. I.D. washers in the following reference trees. \* Exist. BT, Cedar 16", S.59 W., 44.74 feet, Blazed. \* Exist. BT, Cedar 24", N.71 W., 44.64 feet, Blazed. \* Exist. BT, W. Birch 18", S.33 E., 42.69 feet, Blazed. \* Spruce 10", N.53 E., 51.19 feet, '1/4S BT'. \* All bearings are magnetic.

Signed by Robert L. Jaaros  
Surveyor's Michigan License No. 25849

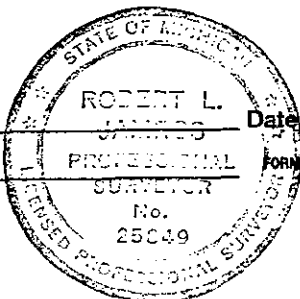

Date 25 March, 1997  
FORM APPROVED BY MICHIGAN STATE BOARD OF PROFESSIONAL SURVEYORS, JAN. 28, 1971  
REVISED MAY 14, 1975  
REVISED JAN., 1983