

Approved by Alger County  
Land Survey Re-monumentation  
Peer Group Under Act 345 of  
P.A. of 1990 On 12-12-1995

Donald W. Jamros  
Chairman

For corners in  
Alger  
(County)

**LAND CORNER RECORDATION CERTIFICATE**  
Filing Requirement of Act 74, Mich. P.A. 1970

RECORDATION  
COMMISSION

JAN 23 1996

COMMISSION  
4-326

**REC'D and FILED**

DEC 20 1995

2:45 p.m.

DONALD W. KIMMEL, County Clerk  
ALGER COUNTY, MI

Register of Deeds Stamp & File Number

	Located In:	Corner Code #
1. Public Land Survey	T <u>49N</u> R <u>13W</u>	<u>C9</u>
	T _____ R _____	_____
	T _____ R _____	_____
	T _____ R _____	_____
2. Property Controlling in Section	S _____ T _____ R _____	_____
	S _____ T _____ R _____	_____
3. Miscellaneous Property in Sec.	S _____ T _____ R _____	_____
	S _____ T _____ R _____	_____

4. Lot No. \_\_\_\_\_, Recorded Plat \_\_\_\_\_  
5. Private Claims \_\_\_\_\_

I, Robert L. Jamros, in a field survey on September 07, 1995, 19\_\_\_\_\_, do hereby certify that under requirements of P.A. 74, Michigan P.A. of 1970, the corner points mentioned in lines 1 and 2 above were in conformance with regulations and rules therefore as required in the current manual of survey instructions of the United States Department of the Interior, Bureau of Land Management or by a decree of a Court of Law and/or that the corner points mentioned in lines 3, 4 and 5 above were in conformance with the rules of the Michigan Board of Land Surveyors or by a Decree of a Court of Law; established, re-established, monumented, re-monumented, recovered, found as expressed below:

**NOTE: Not more than 4 corners, all in the same town and range, may be recorded on this certificate.**

	A	B	C	D	E	F	G	H	I	J	K	L	A
2	6	5	4	3	2	1							
3													
4	7	8	9	10	11	12							
5													
6	18	17	16	15	14	13							
7													
8	19	20	21	22	23	24							
9													
10	30	29	28	27	26	25							
11													
12	31	32	33	34	35	36							
13													

**A. Description of original monument and accessories and/or subsequent restoration:**


C9: PLS-Francis Coleman, DS, 1851, Set post corner of sections 19,20,29 & 32 - Fir 12", N.21 W., 27 links, Beech 7", S.63 E., 30 links. Alger County Records, George L. Depew, 1916, Set iron corner from original government field notes. No references given. Record of surveys book, page 264. Alger County Records. CCI Forestry Division, Land and Timber Examination Report. T.J. McLaren, 1957, on timber cruise sheet indicates an iron at corner position set by author unknown. No references given.

**B. Description of corner evidence found and/or method applied in restoring or reestablishing corner:**

C9: Found 2" 6.I.P. w/ 3 1/4" Brass cap stamped to identify corner position, dated March 1916. A search was made at 6LO bearing tree positions. Bearing tree evidence has been lost. Monument position is accepted as a careful and faithful perpetuation of the position of the original corner.

**C. Description of monument for corner and accessories established to perpetuate locating the position of the corner:**

C9: Stamped P.A. 345 in brass cap of cast steel monument. Established the following reference trees w/ BT signs, blazed, scribed and painted. Set PK nails for measure w/ Alum. I.D. washers in the following reference trees. Maple 11", N.52 E., 28.98 feet, " S20 BT ", Maple 8", S.74 E., 14.95 feet, " S29 BT ", Maple 4", N.43 W., 54.75 feet, " S19 BT ", Beech 4", S.68 W., 45.44 feet, " S30 BT ", Survey Marker sign on six foot steel fence post, N.28 W., 1.5 feet. All bearings are magnetic.

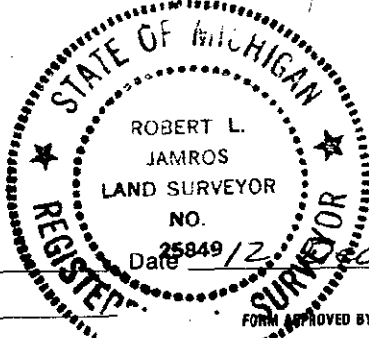

Signed by Robert L. Jamros  
Surveyor's Michigan License No. 25849