

Approved by Alger County
Land Survey Remuneration
Peer Group Under Act 345 of
P.A. of 1990 On 5-18 1994

Robert L. Jamros
Chairman

LAND CORNER RECORDATION CERTIFICATE
Filing Requirement of Act 74, Mich. P.A. 1970

4-219

For corners in


Alger (County)	Located In:	Corner Code #
1. Public Land Survey	T <u>49N</u> R <u>13W</u>	<u>05</u>
	T _____ R _____	_____
	T _____ R _____	_____
	T _____ R _____	_____
2. Property Controlling in Section	S _____ T _____ R _____	_____
	S _____ T _____ R _____	_____
3. Miscellaneous Property in Sec.	S _____ T _____ R _____	_____
	S _____ T _____ R _____	_____

Recorded May 26, 1994
at 8:00 o'clock A. M., and
Recorded in Liber 4 of Corner Rec.
on Page 219

Robert L. Jamros
Alger County Register of Deeds

Register of Deeds Stamp & File Number

4. Lot No. _____, Recorded Plat _____
5. Private Claims _____

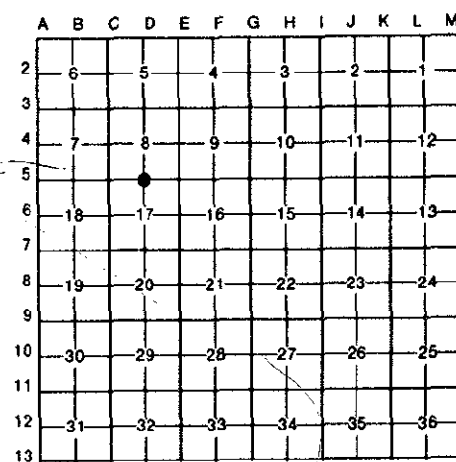

I, Robert L. Jamros, in a field survey on September 25, 1993, 19____, do hereby certify that under requirements of P.A. 74, Michigan P.A. of 1970, the corner points mentioned in lines 1 and 2 above were in conformance with regulations and rules therefore as required in the current manual of survey instructions of the United States Department of the Interior, Bureau of Land Management or by a decree of a Court of Law and/or that the corner points mentioned in lines 3, 4 and 5 above were in conformance with the rules of the Michigan Board of Land Surveyors or by a Decree of a Court of Law; established, re-established, monumented, re-monumented, recovered, found as expressed below:

NOTE: Not more than 4 corners, all in the same town and range, may be recorded on this certificate.

A. Description of original monument and accessories and/or subsequent restoration:

D5: P.L.S. - Francis Coleman, D5, 1851. Set Or. Sec. post - Beech 8, N.69 W., 20 links. Fir 6, S.50 E., 14 links. C.C.I. Forestry, McLaren, 1968, Post set from original BT, Beech 8, N.69 W., 20 links. Set witness Beech 3, S.07 E., 12.2 ft., Beech 10, N.43 E., 7.0 ft.

B. Description of corner evidence found and/or method applied in restoring or reestablishing corner:

D5: Began at Southwest Corner of Section 8 at a BT corner and ran corrected compass line to 77.00 chains, enter swamp, Beech 16 and marked call at 76.86 chains. Continued on corrected compass line to 70.67 chains and 44.81 chains Maple 16. Found no evidence at line tree locations. Area is open and has been cultivated over the years. Continued on corrected compass line to 39.77 chains and found 4" squared post, 17 feet South of compass line. At post set directions and distances of G.L.O. BT's. At N.69 W., 20 links found decayed remains of Beech in stump mound. At S.50 E., 14 links found decayed remains of Fir in stump hole. Installed monument at post location and established new reference trees and is accepted as a careful and faithful perpetuation of the position of the original corner. Corner lies in open mixed hardwoods.

C. Description of monument for corner and accessories established to perpetuate locating the position of the corner:

D5: Installed 2 1/4" Alum. mon. w/ 3 1/4" Alum. cap in post point hole stamped to I.D. corner position. Est. reference trees w/BT signs, blazed, scribed and painted. Set PK nails for measuring w/brass I.D. washers in the following reference trees. Exist - Beech 18", N.38 E., 7.41 ft., "1/4S-BT". Beech 7", S.60 W., 32.75 ft., "1/4S-BT". Beech 18", N.65 W., 34.17 ft., "1/4S-BT". Exist - Beech 8", S.11 E., 12.64 ft., "1/4S-BT". Sur. Marker Post.

Signed by Robert L. Jamros Date 2 May, 1994
Surveyor's Michigan License No. 25849