

Approved by Alger County
Land Survey Remonumentation
Peer Group Under Act 345 of
P.A. of 1990 On 5-18-1994

Robert L. Jamros
Chairman

LAND CORNER RECORDATION CERTIFICATE
Filing Requirement of Act 74, Mich. P.A. 1970

4-217

For corners in
Alger
(County)

Located In: Corner Code #

1. Public Land Survey T 49N R 13W E3
T R
T R SURVEY &
T R REMONUMENTATION
2. Property Controlling S T R
in Section S T R
3. Miscellaneous S T R
Property in Sec. S T R MAY 10 1995
4. Lot No. _____, Recorded Plat _____ COMMISSION
5. Private Claims _____

Recorded May 26, 1994
at 8:00 o'clock A. M., and
Recorded in Liber 4 of Corner Rec
on Page 217

David W. Kimmensen
Alger County Register of Deeds

Register of Deeds Stamp & File Number

I, Robert L. Jamros, in a field survey on June 19, 1993, 19_____, do hereby certify that under requirements of P.A. 74, Michigan P.A. of 1970, the corner points mentioned in lines 1 and 2 above were in conformance with regulations and rules therefore as required in the current manual of survey instructions of the United States Department of the Interior, Bureau of Land Management or by a decree of a Court of Law and/or that the corner points mentioned in lines 3, 4 and 5 above were in conformance with the rules of the Michigan Board of Land Surveyors or by a Decree of a Court of Law; established, re-established, monumented, re-monumented, recovered, found as expressed below:

NOTE: Not more than 4 corners, all in the same town and range, may be recorded on this certificate.

A. Description of original monument and accessories and/or subsequent restoration:


E3: P.L.S. - Francis Coleman, DS, 1851. Set post corner of Secs. 4, 5, 8 and 9. Beech 14, N.31 W., 10 links. Sugar 12, S.45 E., 21 links. James Roundtree, County Surveyor, 1908, iron driven according to field notes and barren trees. Billy D. Buckler, RLS, 1973 found concrete plat mon., buried in inter. of roads, N, S, and W, A.C.Rec.No.31. Gerald W. Carlson, RLS, 1984, Fd. Conc. Mon. and 3" brass cap., Accepted and used brass cap on pipe. Conc. Mon. is S67-53-59 E., 11.55' of brass cap on pipe. A.C.Rec.No.4-16. Robert L. Jamros, RLS, 1986, found G.I.P. w/brass cap in "T" inter. of grav. rd's, also found 4" sq. conc. mon. 11.55 feet east of Section corner. A.C.Rec.No.3-56.

B. Description of corner evidence found and/or method applied in restoring or reestablishing corner:

E3: Located corner position at the intersection of Webb Road and East Bay Road, both gravel. With the aid of existing reference points the corner monument was uncovered. Found 3 1/4 inch Brass cap Alger County standard monument one foot below surface of gravel road. Stamped PA 345 in existing cap and renewed existing BT's and established new reference point. Corner monument is Alger County Standard corner of the past, and is accepted as a careful and faithful perpetuation of the position of the original corner.

C. Description of monument for corner and accessories established to perpetuate locating the position of the corner:

E3: Existing G.I.P. w/3 1/4" Brass cap w/stampings to I.D. corner position. Est. reference trees w/BT signs, blazed, and painted. Set PK nails for measuring w/brass I.D. washers in the following reference trees & Power Pole. Exist - Maple Clump, N.37 W., 54.52 ft., Exist - Beech 14", S.77 E., 50.21 ft., Exist - R. Maple 9", S.30 W., 46.72 ft., Power Pole, S.37 E., 47.05 ft., Scrd. BT

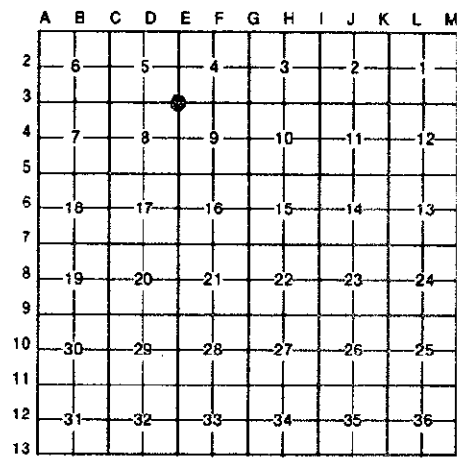

Signed by Robert L. Jamros
Surveyor's Michigan License No. 25849

Date 2 May 1994