

Approved by Alger County  
Land Survey Remonumentation  
Peer Group Under Act 345 of  
P.A. of 1990 On 4-8 1995

Merrill W. Carlson  
Chairman

**LAND CORNER RECORDATION CERTIFICATE**  
Filing Requirement of Act 74, Mich. P.A. 1970

4-280

For corners in

<u>Alger</u> (County)	Located In:	Corner Code #
1. Public Land Survey	T <u>49N</u> R <u>13W</u>	<u>G3</u>
	T _____ R _____	_____
	T _____ R _____	_____
2. Property Controlling in Section	S _____ T _____ R _____	<u>SURVEY &amp;</u>
	S _____ T _____ R _____	<u>REMONUMENTATION</u>
3. Miscellaneous Property in Sec.	S _____ T _____ R _____	_____
	S _____ T _____ R _____	_____
4. Lot No. _____, Recorded Plat _____		
5. Private Claims _____		

FILED  
TIME 9:00 a.m.

APR 20 1995


DONALD W. KINNUNEN  
REGISTER OF DEEDS

Register of Deeds Stamp & File Number

MAY 10 1995

COMMISSION

I, Robert L. Jamros, in a field survey on October 21, 1994, 19\_\_\_\_, do hereby certify that under requirements of P.A. 74, Michigan P.A. of 1970, the corner points mentioned in lines 1 and 2 above were in conformance with regulations and rules therefore as required in the current manual of survey instructions of the United States Department of the Interior, Bureau of Land Management or by a decree of a Court of Law and/or that the corner points mentioned in lines 3, 4 and 5 above were in conformance with the rules of the Michigan Board of Land Surveyors or by a Decree of a Court of Law; established, re-established, monumented, re-monumented, recovered, found as expressed below:

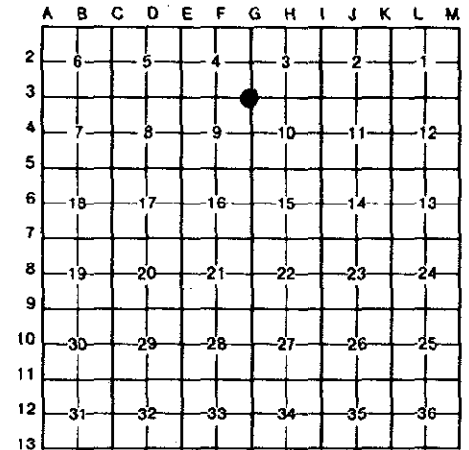

**NOTE: Not more than 4 corners, all in the same town and range, may be recorded on this certificate.**

**A. Description of original monument and accessories and/or subsequent restoration:**

G3: PLS-Francis Coleman, DS, 1851, Set post corner of Sections 3,4,9, and 10 - Fir 10", N.75 E., 10 links, Cedar 5", S.61 W., 13 links. A.C.R.C., H.H.Anderson, CE, 1935, Road alignment of Grand Marais East. Corner position noted 412 ft. N. of centerline of road. No references given. CCI Forestry Division, Land and Timber Examination Reports, R.J. Brotherton, RLS, 1941, found L.E.S. white post and down GLO cedar BT. No references given. AND White post, J.R.Radcliffe, 1949, no references given, AND Down Cedar BT, T.J.McClaren, 1949, No references given., AND Set post and iron, Found identifiable marks on old down Cedar BT, T.J.McClaren, 1963. References: Cedar 6", S.84 E., 7.9 ft., Balsam 4", N.29 W., 8.8 ft., Billy D. Buckler, RLS, 1973, found original cedar BT in poor condition with wood post at corner, also found 1" x 24" iron bar in the ground. New Bearings, 13" Cedar, S.10 W., 22.1 ft., and 8" Cedar, S.23 E., 31.5 ft., Recorded in corner record No. 31, Alger County Records.

**B. Description of corner evidence found and/or method applied in restoring or reestablishing corner:**

G3: Found corner position with Michigan Department of Conservation Forestry Division monument approx. 400 ft. N. of County Road H-58. Found remains of GLO original Cedar BT in SW position badly decayed, location measures direction and distance from existing M.D.C.F.D. monument. Found all bearing trees from report of 1973 dead and down. Existing monument is accepted as a careful and faithful perpetuation of the position of the original corner.

**C. Description of monument for corner and accessories established to perpetuate locating the position of the corner:**

G3: Stamped P.A. 345 in Alum. Cap of 1 1/4" galvanized iron pipe monument. Monument is in sound condition. Established reference trees w/ BT signs, blazed, scribed and painted. Set PK nails for measure w/ brass I.D. washers in the following reference trees. Balsam Fir 4", S.62 W., 15.04 feet, (Scribed only) 'S9 BT', Cedar 7", N.68 1/2 W., 25.39 feet, 'S4 BT', Cedar 6", N.56 E., 12.04 feet, 'S3 BT', Hemlock 14", S.45 E., 16.86 feet, 'S10 BT', Steel witness post with Survey marker sign, S.41 E., 1.5 feet, All bearings are magnetic.

Signed by Robert L. Jamros  
Surveyor's Michigan License No. 25849

Date 12 April, 1995