

Approved by Alger County
Land Survey Remonumentation
Peer Group Under Act 345 of
P.A. of 1990 On 12-12-1995

ALGER COUNTY
SURVEY &
REMONUMENTATION

JAN 23 1996

COMMISSION

4-321


Donald W. Kinnunen
Chairman

LAND CORNER RECORDATION CERTIFICATE
Filing Requirement of Act 74, Mich. P.A. 1970

For corners in Alger (County)	Located In:	Corner Code #
1. Public Land Survey	T <u>49N</u> R <u>13W</u>	<u>H3</u>
	T _____ R _____	_____
	T _____ R _____	_____
	T _____ R _____	_____
2. Property Controlling in Section	S _____ T _____ R _____	_____
	S _____ T _____ R _____	_____
3. Miscellaneous Property in Sec.	S _____ T _____ R _____	_____
	S _____ T _____ R _____	_____

REC'D and FILED
DEC 20 1995
2:45 p.m.
DONALD W. KINNUNEN, County Clerk
ALGER COUNTY, MI
Register of Deeds Stamp & File Number

4. Lot No. _____, Recorded Plat _____
5. Private Claims _____

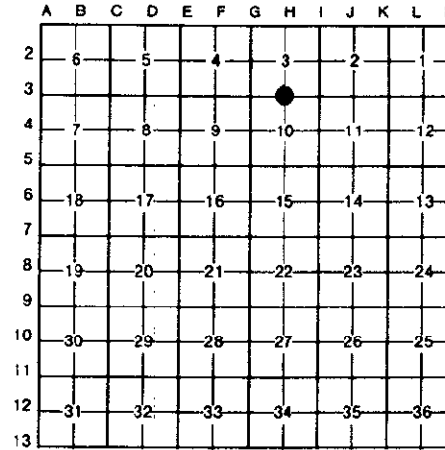

I, Robert L. Jamros, in a field survey on June 14, 1995, 19_____, do hereby certify that under requirements of P.A. 74, Michigan P.A. of 1970, the corner points mentioned in lines 1 and 2 above were in conformance with regulations and rules therefore as required in the current manual of survey instructions of the United States Department of the Interior, Bureau of Land Management or by a decree of a Court of Law and/or that the corner points mentioned in lines 3, 4 and 5 above were in conformance with the rules of the Michigan Board of Land Surveyors or by a Decree of a Court of Law; established, re-established, monumented, re-monumented, recovered, found as expressed below:

NOTE: Not more than 4 corners, all in the same town and range, may be recorded on this certificate.

A. Description of original monument and accessories and/or subsequent restoration:


H3; PLS-Francis Coleman, DS, 1851, Set Or. Section Post- Hemlock 18", N.17 E., 30 links, Hemlock 16", S.32 W., 17 links. CCI Forestry Division, Land and Timber Examination Report. T.J. McLaren, 1949, indicates on timber cruise sheet a 6" post at corner location. CCI Land Corner Record page 7C, T.J. McLaren, 1963 through present, Set post and iron at mid-point between section corners east and west on corrected line. New references as follows: Cedar 6", N.38 W., 10.4 feet, Cedar 6", N.31 E., 8.3 feet.

B. Description of corner evidence found and/or method applied in restoring or reestablishing corner:

H3: Established corner position by field survey on line at proportional distance between section corners East and West. Found 1" square iron bar N.07 W., 18.0 feet. Believed to be iron set by T.J. McLaren. A search was made at GLO bearing tree positions, evidence was inconclusive. Corner position is accepted as a careful and faithful reestablishment of the original corner.

C. Description of monument for corner and accessories established to perpetuate locating the position of the corner:

H3: Set Berntsen Mon. no. A1NB30, stamped to identify corner position. Established the following reference trees, w/ BT signs, blazed, scribed and painted. Set PK nails for measure w/ Alum. I.D. washers in the following reference trees. Cedar 7" S.70 W., 8.20 feet, " 1/4s BT ", Cedar 10", N.38 W., 15.94 feet, " 1/4s BT ", Cedar 18", N.43 E., 38.10 feet, " 1/4s BT ", Blk. Spruce 9", S.30 E., 3.11 feet, " 1/4s BT ", Survey Marker sign on six foot steel fence post, N.40 E., 1.3 feet. All bearings are magnetic.

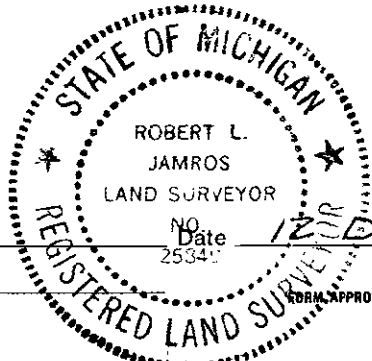

Signed by Robert L. Jamros
Surveyor's Michigan License No. 25849

Date 12 December 1995