

SURVEY & REMONUMENTATION

FEB 19 1998

Approved by Almer County
Land Survey Remonumentation
Peer Group Under Act 345 of
P.A. of 1990 On 12-10-97

05-82

SECTION LAND CORNER RECORDATION CERTIFICATE Filing Requirement of Act 74, Mich. P.A. 1970

For corners in _____

(County)

Located In:

Corner Code #

		49	13	I2	
1. Public Land Survey	T	___	R	___	___
	T	___	R	___	___
	T	___	R	___	___
	T	___	R	___	___
2. Property Controlling in Section	S	___	T	___	___
	S	___	T	___	___
3. Miscellaneous Property in Section	S	___	T	___	___
	S	___	T	___	___

FILED
TIME 8:30 A.M.

DEC 17 1997

DONALD W. KINNUNEN
REGISTER OF DEEDS
ALMER COUNTY, MI

Register of Deeds Stamp & File Number

4. Lot No. _____, Recorded Plat _____
5. Private Claims _____

	A	B	C	D	E	F	G	H	I	J	K	L	M
2	6	5	4	3	2	1							
3													
4	7	8	9	10	11	12							
5													
6	18	17	16	15	14	13							
7													
8	19	20	21	22	23	24							
9													
10	30	29	28	27	26	25							
11													
12	31	32	33	34	35	36							
13													

I, Robert L. Jamros, in a field survey on November 20, 1997, 19_____, do hereby certify that under requirements of P.A. 74, Michigan P.A. of 1970, the corner points mentioned in lines 1 and 2 above were in conformance with regulations and rules therefore as required in the current manual of survey instructions of the United States Department of the Interior, Bureau of Land Management or by a decree of a Court of Law and/or that the corner points mentioned in lines 3, 4 and 5 above were in conformance with the rules of the Michigan Board of Professional Surveyors or by a Decree of a Court of Law; established, re-established, monumented, re-monumented, recovered, found as expressed below:

NOTE: Not more than 4 corners, all in the same town and range, may be recorded on this certificate.

A. Description of original monument and accessories and/or subsequent restoration:

I2: P.S. - Francis Coleman, DS, 1851, Set quarter section post - White Birch 8, N.63 E., 71 links * White Birch 9, S.61 W., 98 links
**** T.J. McLaren, 1949 * C.C.I. Co., Land and Timber Report * Indicates a 6 inch squared post **** No other subsequent restoration on record.

B. Description of corner evidence found and/or method applied in restoring or reestablishing corner:


I2: Located corner position by field survey * Position lies in a replanted pine plantation * Evidence of a paint and flagging line running West from located corner position * Sucker River lies North of the corner position approximately 125 feet, GLO calls for 230 feet, river subject to erosion. * T.J. McLaren for C.C.I. Co. on 1949 report indicates graphically the Sucker River to be 120 feet (by scale) North of 6 inch squared post * Found 3 inch iron pipe S.05 W., 67.1 feet from corner position * GLO original BT positions are lost * Established corner position by single proportionate measurement between section corners North and South * Corner position is accepted as a careful and faithful reestablishment of the position of the original corner.

C. Description of monument for corner and accessories established to perpetuate locating the position of the corner:

I2: Set Berntsen Alum. monument no. A1NB30, stamped to identify corner position * Established reference trees with BT signs, blazed and scribed * Set PK nails w/Alum. I.D. washers for measure in the following - Red Pine 8, S.35 W., 36.0 feet, "BT" * Red Pine 10, N.50 W., 36.05 feet, "BT" * Red Pine 9, N.57 E., 24.15 feet, "BT" * Red Pine 12, S.49 E., 19.85 feet, "BT" * Survey marker sign on 6 foot steel post, S.35 W., 1.7 feet * All bearings are magnetic.

Signed by Robert L. Jamros
Surveyor's Michigan License No. 25849

Date 12/10/1997

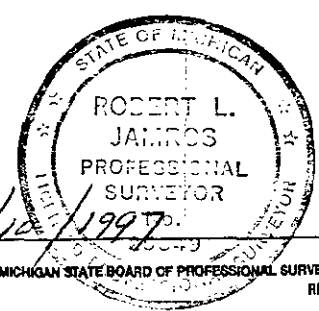

FORM APPROVED BY MICHIGAN STATE BOARD OF PROFESSIONAL SURVEYORS, JAN. 28, 1971
REVISED MAY 14, 1975
REVISED JAN., 1983