

SURVEY & REMONUMENTATION

FEB 19 1998

Approved by Alger County Land Survey Remonumentation Peer Group Under Act 345 of P.A. of 1990 On 12-10-1997

SECTION

05-79

LAND CORNER RECORDATION CERTIFICATE Filing Requirement of Act 74, Mich. P.A. 1970

Chairman Gerald W. Carlson

Table with columns: For corners in (County), Located In:, Corner Code #. Rows include Public Land Survey, Property Controlling in Section, Miscellaneous Property in Section.

FILED TIME 8:30 A.M.


DEC 17 1997

DONALD W. KINNUNEN REGISTER OF DEEDS ALGER COUNTY, MI

Register of Deeds Stamp & File Number

4. Lot No. , Recorded Plat
5. Private Claims

I, Robert L. Jamros, in a field survey on June 17, 1997, 19 do hereby certify that under requirements of P.A. 74, Michigan P.A. of 1970, the corner points mentioned in lines 1 and 2 above were in conformance with regulations and rules therefore as required in the current manual of survey instructions of the United States Department of the Interior, Bureau of Land Management or by a decree of a Court of Law and/or that the corner points mentioned in lines 3, 4 and 5 above were in conformance with the rules of the Michigan Board of Professional Surveyors or by a Decree of a Court of Law; established, re-established, monumented, re-monumented, recovered, found as expressed below:

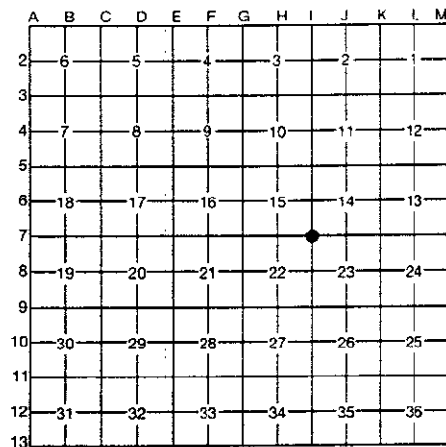

NOTE: Not more than 4 corners, all in the same town and range, may be recorded on this certificate.

A. Description of original monument and accessories and/or subsequent restoration:

17: PLS - Francis Colman, DS, 1851 * Set corner of Sections 14, 15, 22 & 23 * Spruce 14, N.40 W., 26 links * Spruce 10, S.15 E., 17 links **** Billy D. Buckler, RLS, M.D. of C., Land Corner Record, 1960 * Set 1 inch iron pipe w/4 inch brass cap * This corner was reestablished by placing it on line and single proportionate measurement between corners set on East, West line dividing township as per original notes * Witnesses - Aspen 7, S.08 W., 68 links * Aspen 8, N.78 W., 84.5 links * Recorded in Liber 2, Page 101, Alger County Corner Records **** J.R. Radcliffe, RLS, C.C.I. Co., Land Corner Record, 1965 * Found 1 inch iron pipe w/4 inch brass cap and witnesses - Aspen 7, S.08 W., 68 links * Aspen 8, N.78 W., 84.5 links * Unrecorded report. **** No other subsequent restoration on record.

B. Description of corner evidence found and/or method applied in restoring or reestablishing corner:

17: Found 1 inch iron pipe w/4 inch brass cap, stamped to identify corner position * Measurements to adjacent corners check well. * Renewed exist. BT's and established additional reference trees * Monument position as found is accepted as a careful and faithful reestablishment of the position of the original corner.

C. Description of monument for corner and accessories established to perpetuate locating the position of the corner:

17: Exist. 1 inch iron pipe w/4 inch brass cap, stamped to identify corner position * Renewed exist. BT's w/BT signs and paint * Established additional reference trees with BT signs, blazed, scribed and painted * Set PK nails w/Alum. I.D. washers in the following - Exist. BT, Aspen 16, N.75 W., 56.10 feet, blazes with notch in lower * Exist. BT, Aspen 14, S.11 W., 45.30 feet, blazes with notch in lower * White Pine 5, S.83 E., 28.34 feet. 'S 23 BT' * Aspen 6, N.30 E., 31.05 feet. 'S 14 BT' * Survey marker sign on 6 foot steel post, N.39 E., 1.0 feet * All bearings are magnetic.

Signed by Robert L. Jamros
Surveyor's Michigan License No. 25849

Date 12/10/1997

