

Approved by Alger County
Land Survey Re-amentation
Peer Group Under Act 345 of
P.A. of 1990 On 3-24 1997

Heald Carlson
Chairman

LAND CORNER RECORDATION CERTIFICATE
Filing Requirement of Act 74, Mich. P.A. 1970

5-32

For corners in
ALGER
(County)

Located In:

Corner Code #

- | | | | | | |
|---|---|------------|---|------------|-----------|
| 1. Public Land Survey | T | <u>49N</u> | R | <u>13W</u> | <u>19</u> |
| | T | | R | | |
| | T | | R | | |
| | T | | R | | |
| 2. Property Controlling
in Section | S | | T | | R |
| | S | | T | | R |
| 3. Miscellaneous
Property in Section | S | | T | | R |
| | S | | T | | R |

FILED
TIME 2:00 p.m.

MAR 31 1997

DONALD W. KINNUNEN
REGISTER OF DEEDS
ALGER COUNTY, MI

Register of Deeds Stamp & File Number

4. Lot No. _____, Recorded Plat _____
5. Private Claims _____

A	B	C	D	E	F	G	H	I	J	K	L	M
2	6		5		4		3		2		1	
3												
4	7		8		9		10		11		12	
5												
6	18		17		16		15		14		13	
7												
8	19		20		21		22		23		24	
9												
10	30		29		28		27		26		25	
11												
12	31		32		33		34		35		36	
13												

I, Robert L. Jamros, in a field survey on October 18, 1996, 19_____, do hereby certify that under requirements of P.A. 74, Michigan P.A. of 1970, the corner points mentioned in lines 1 and 2 above were in conformance with regulations and rules therefore as required in the current manual of survey instructions of the United States Department of the Interior, Bureau of Land Management or by a decree of a Court of Law and/or that the corner points mentioned in lines 3, 4 and 5 above were in conformance with the rules of the Michigan Board of Professional Surveyors or by a Decree of a Court of Law; established, re-established, monumented, re-monumented, recovered, found as expressed below:

NOTE: Not more than 4 corners, all in the same town and range, may be recorded on this certificate.

A. Description of original monument and accessories and/or subsequent restoration:

19: PLS - Francis Colman, DS, 1851, Set post corner of Sections 22-23-26 & 27 * Y. Birch 16, N.58 W., 11 links * Y. Birch 16, S.77 E., 7 links **** C.C.I.Co., Ray J. Brotherton, RLS, 1952. * Set 5' Poplar post. * Corner was reset by lines run from Govt. line trees and line crossings on adjoining sections. Chained 80.57 chains from the section corner to the North and line was corrected on 2 1/2 degrees right of the needle. * Witness, 38' W. Pine stump, N.30 E., 17 1/2 links. * 18' Maple, S.80 E., 53 1/2 links. **** Michigan Department of Conservation, Billy D. Buckler, RLS, 1960. * Set 1' Iron pipe with 4' Brass cap. * This corner was re-established by proportionate measurement and in a straight line between Section corner for 34,35,3,2, T.48-49 N., R.13 W., which is an original corner, and from 15,14,22,23. * Witness, 36' W. Pine stump, (S 23 NBT), N.51 E., 52 links. * 14' Black Cherry, (S 26 NBT), S.39 E., 95 links. * Recorded in L.2, P.88, Alger County Records. **** C.C.I.Co., J.R. Radcliffe, RLS, 1966. * Found 1' Iron pipe w/ 4' Brass cap and two references set June 27, 1960 by Billy D. Buckler, RLS. * Unrecorded.

B. Description of corner evidence found and/or method applied in restoring or reestablishing corner:


19: Found 1' Iron pipe w/ 4' Brass cap disturbed and the witness of the 1960 and 1966 reports destroyed. Corner position lies approx. fifty feet NEly of NW-SE two track trail. * Reset existing monument and established new references. * Existing monument as found is accepted as a careful and faithful reestablishment of the position of the original corner.

C. Description of monument for corner and accessories established to perpetuate locating the position of the corner:

19: Stamped P.A. 345 on existing Brass capped monument. * Established reference trees w/ BT signs, blazed, scribed and painted. * Set PK nails for measure w/ Alum. I.D. washers in the following reference trees. * W. Pine 5", N.61 W., 30.52 feet, "S22 BT". * W. Pine 6", N.79 E., 28.45 feet, "S23 BT". * W. Pine 16", S.59 E., 52.22 feet, "S26 BT". * W. Pine 8", S.40 W., 32.88 feet, "S27 BT". * Survey marker sign on six foot steel post, N.51 E., 1.5 feet, * All bearings are magnetic.

Signed by Robert L. Jamros

Surveyor's Michigan License No. 25849

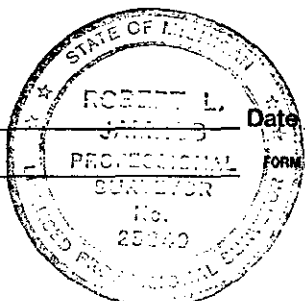

Date 25 March, 1997

FORM APPROVED BY MICHIGAN STATE BOARD OF PROFESSIONAL SURVEYORS, JAN. 25, 1971
REVISED MAY 14, 1975
REVISED JAN., 1983