

# SURVEY & REMONUMENTATION

FEB 19 1998

Approved by Alger County  
Land Survey Remonumentation  
Peer Group Under Act 345 of  
P.A. of 1990 Ch. 12-10, 1997

05-77

## SECTION LAND CORNER RECORDATION CERTIFICATE Filing Requirement of Act 74, Mich. P.A. 1970

For corners in \_\_\_\_\_

(County)

Located In: \_\_\_\_\_

Corner Code # \_\_\_\_\_

1. Public Land Survey  2. Property Controlling in Section  3. Miscellaneous Property in Section	T T T T  S S S S	_____ _____ _____ _____  _____ _____ _____ _____	R R R R  T T T T	_____ _____ _____ _____  _____ _____ _____ _____	_____ _____ _____ _____  _____ _____ _____ _____
---	--	--	--	--	--


FILED  
TIME 8:30 A.M.

DEC 17 1997

DONALD W. KINNUNEN  
REGISTER OF DEEDS  
ALGER COUNTY, MI

Register of Deeds Stamp & File Number

4. Lot No. \_\_\_\_\_, Recorded Plat \_\_\_\_\_  
 5. Private Claims \_\_\_\_\_

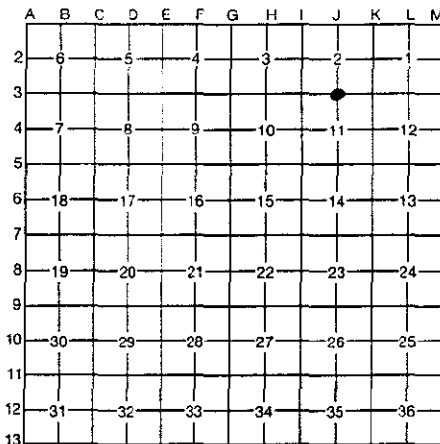

I, Robert L. James, in a field survey on October 31, 1997, 19\_\_\_\_\_, do hereby certify that under requirements of P.A. 74, Michigan P.A. of 1970, the corner points mentioned in lines 1 and 2 above were in conformance with regulations and rules therefore as required in the current manual of survey instructions of the United States Department of the Interior, Bureau of Land Management or by a decree of a Court of Law and/or that the corner points mentioned in lines 3, 4 and 5 above were in conformance with the rules of the Michigan Board of Professional Surveyors or by a Decree of a Court of Law; established, re-established, monumented, re-monumented, recovered, found as expressed below:

**NOTE: Not more than 4 corners, all in the same town and range, may be recorded on this certificate.**

**A. Description of original monument and accessories and/or subsequent restoration:**


J3: PLS - Francis Dolman, DS, 1851 \* Set quarter section post \* Aspen 6, N.43 E., 71 links \* Aspen 4, S.65 W., 11 links \*\*\*\* No other subsequent restoration on record.

**B. Description of corner evidence found and/or method applied in restoring or reestablishing corner:**

J3: Established corner position by field survey \* Corner position lies in plantation of Jack Pine and Red Pine of a replanted area \* Found 3 inch iron pipe and a Red Pine 22, w/blazes in all quadrants, S.74W., 196.7 feet from located corner position \* No other evidence around corner position \* Corner position established on true line at mid point between section corners East and West \* Corner position is accepted as a careful and faithful reestablishment of the position of the original corner.

**C. Description of monument for corner and accessories established to perpetuate locating the position of the corner:**

J3: Set Berntsen Alum. monument no. A1NB30, stamped to identify corner position \* Established reference trees w/BT signs, blazed, scribed and painted \* Set PK nails w/Alum. I.D. washers in the following - Red Pine 8, S.54 W., 38.02 feet, "1/4S BT" \* Red Pine 8, N.79 W., 35.65 feet, "1/4S BT" \* Jack Pine 6, N.29 E., 6.24 feet, "1/4S BT" \* Jack Pine 6, S.67 E., 7.76 feet, "1/4S BT" \* Survey marker sign on 1 foot steel post, N.49 W., 1.2 feet \* All bearings are magnetic.

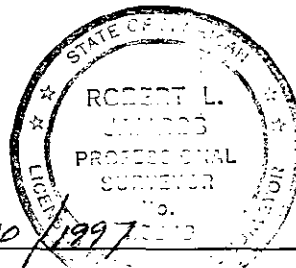

Signed by Robert L. James  
 Surveyor's Michigan License No. 25849

Date 12/10/1997