

DEC 27 1999

Approved by Alger County Land Survey Re-mentoriation Peer Group Under Act 945 of P.A. of 1990 On 12-8-1999

*Donald W. Kinnunen*  
Chairman

05-149

For corners in

LAND CORNER RECORDATION CERTIFICATE  
Filing Requirement of Act 74, Mich. P.A. 1970

SECTION

ALGER

(County)

Located In:

Corner Code #


- 1. Public Land Survey      T 49N R 13W      K9
- T        R
- T        R
- T        R
- 2. Property Controlling    S        T        R
- in Section                S        T        R
- 3. Miscellaneous            S        T        R
- Property in Section      S        T        R

FILED  
TIME 1:30 p.m.

DEC 15 1999

DONALD W. KINNUNEN  
REGISTER OF DEEDS  
ALGER COUNTY, MI  
Register of Deeds Stamp & File Number

- 4. Lot No. \_\_\_\_\_, Recorded Plat \_\_\_\_\_
- 5. Private Claims \_\_\_\_\_

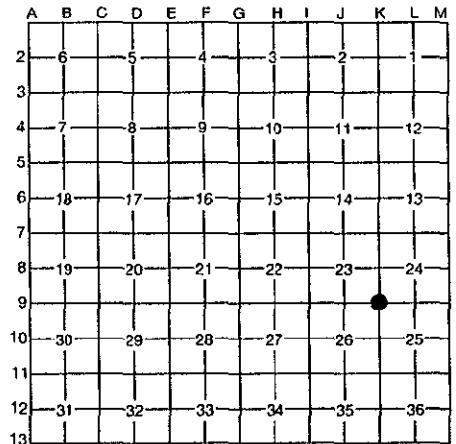

I, Robert L. Jamros, in a field survey on June 22, 1999, 19\_\_\_\_\_, do hereby state that under requirements of P.A. 74, Michigan P.A. of 1970, the corner points mentioned in lines 1 and 2 above were in conformance with regulations and rules therefore as required in the current manual of survey instructions of the United States Department of the Interior, Bureau of Land Management or by a decree of a Court of Law and/or that the corner points mentioned in lines 3, 4 and 5 above were in conformance with the rules of the Michigan Board of Land Surveyors or by a Decree of a Court of Law; established, re-established, monumented, \_\_\_\_\_ recovered, found as expressed below:

NOTE: Not more than 2 corners, all in the same town and range, may be recorded on this certificate.

A. Description of original monument and accessories and/or subsequent restoration:

K9: Francis Colman, DS, 1851. \* Set post corner of Sections 23, 24, 25 & 26. \* Maple 7", N.10 W., 29 links. \* Maple 7", S.64 E., 27 links. \*\*\*\* Michigan Department of Conservation, Forestry Division. \* Billy D. Buckler, RLS, 1960. \* Corner was reestablished by setting it on line and proportionate measurement between corners set on 3 mile random as per original survey notes. \* Set 1" iron pipe with 4" brass cap. \* Witnesses: 8" B.Cherry (S24 NBT), N.26 E., 11 links. \* 18" W.Pine stub (S23 NBT), N.45 W., 59 links; \* 28" W.Pine stump (S25 NBT), S.87 E., 148 links. \* Liber 2, Page 102, Alger County Corner Records. \*\*\*\* No other subsequent restoration of record.

B. Description of corner evidence found and/or method applied in restoring or reestablishing corner:

K9: Located corner by calculated position and standard field survey methods and found corner monument in good condition and position. \* Found only 1 reference tree of the 1960 report. \* Renewed existing reference tree and established additional reference trees. \* Corner position as found is accepted as a careful and faithful reestablishment of the position of the original corner.

C. Description of monument for corner and accessories established to perpetuate locating the position of the corner:

K9: Existing 1" iron pipe with 4" brass cap. \* Renewed the following existing trees with BT signs and paint. \* Established additional references with BT signs, blazed, scribed and painted. \* Set PK nails for measure with aluminum I.D. washers in the following: Existing - B.Cherry 16", N.29 E., 7.43 feet, upper and lower blaze scars. \* W.Cherry 10", S.72 E., 69.32 feet, "S25 BT". \* Twin W.Cherry 14"-18", S.11 E., 73.79 feet, "S25 BT". \* W.Cherry 14", S.72 W., 29.23 feet, "S26 BT". \* Survey marker sign on 6 foot steel post, West 1.5 feet. \* All bearings are magnetic.

Signed by *Robert L. Jamros* Date Dec 13 1999  
Surveyor's Michigan License No. 25849

