

JAN 18 2001

Approved by Alger County  
Land Survey Remonumentation  
Peer Group Under Act 345 of  
P.A. of 1990 On 12-13-2000

Donald W. Carlson  
Chairman


SECTION LAND CORNER RECORDATION CERTIFICATE  
Filing Requirement of Act 74, Mich. P.A. 1970

Alger (County)	Located In:	Corner Code #
1. Public Land Survey	T 49N R 13W	G11
	T R	
	T R	
	T R	
2. Property Controlling in Section	S T R	
	S T R	
3. Miscellaneous Property in Section	S T R	
	S T R	

05-194  
FILED  
TIME 8:50 AM  
DEC 20 2000  
DONALD W. KINNUNEN  
REGISTER OF DEEDS  
ALGER COUNTY, MI  
Register of Deeds Stamp & File Number

4. Lot No. \_\_\_\_\_, Recorded Plat \_\_\_\_\_  
5. Private Claims \_\_\_\_\_

I, Robert L. Jamros, in a field survey on September 21, 2000, do hereby state that under requirements of P.A. 74, Michigan P.A. of 1970, the corner points mentioned in lines 1 and 2 above were in conformance with regulations and rules therefore as required in the current manual of survey instructions of the United States Department of the Interior, Bureau of Land Management or by a decree of a Court of Law and/or that the corner points mentioned in lines 3, 4 and 5 above were in conformance with the rules of the Michigan Board of Land Surveyors or by a Decree of a Court of Law; established, re-established, monumented, recovered, found as expressed below:

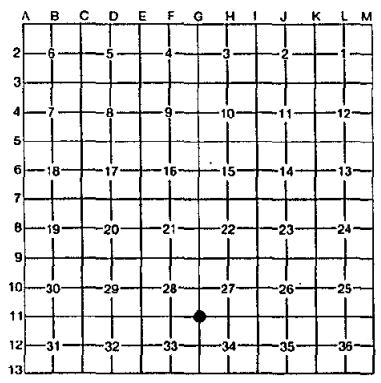

NOTE: Not more than 2 corners, all in the same town and range, may be recorded on this certificate.

A. Description of original monument and accessories and/or subsequent restoration:

G11: PLS Francis Colman, DS, 1851. 81.07 chains, set post corner of Sections 27, 28, 33 and 34. Spruce 10", N.53°E., 14 links. Hemlock 8", S.48°W., 18 links. \*\*\*\*\* No other subsequent restoration of record.

B. Description of corner evidence found and/or method applied in restoring or reestablishing corner:

G11: Established corner position by single proportionate measurement and on line between section corner 1 mile North and quarter section corner 1/2 mile South. No corner monument found. Found 6" wood post with flat sided face marked "Approx. Corner 27, 28, 33, 34", down and semi buried, 6 feet South and 25 feet West of corner position. Corner position lies in dirt road near West edge of same. No original G.L.O. evidence was found at corner. G.L.O. terrain calls to North and South check reasonable well. Corner position as established is accepted as a careful and faithful reestablishment of the position of the original corner.

C. Description of monument for corner and accessories established to perpetuate locating the position of the corner:

G11: Set 5/8" x 18" rebar with 3/4" aluminum cap no. RBD5325, stamped to identify corner position. Established the following references with BT signs, blazed, scribed and painted. Set PK nails for measure with aluminum I.D. washers in the following: Spruce 5", N.48°W., 26.44 feet (S28 BT); Spruce 6", N.77°E., 10.68 feet (S27 BT); Spruce 8", S.07°E., 39.71 feet (S34 BT); Spruce 5", S.74°W., 26.28 feet (S33 BT). Survey marker sign on 6 foot steel post. S.78°E., 8.0 feet. All bearings are magnetic.

Signed by Robert L. Jamros  
Surveyor's Michigan License No. 25849

Date DEC 17, 2000

