

DEC 27 1999

Approved by Alger County
Land Survey Remonumentation
Peer Group Under Act 345 of
P.A. of 1990 On 12-8-1999

Donald W. Kinnunen
Chairman

For corners in

SECTION

LAND CORNER RECORDATION CERTIFICATE
Filing Requirement of Act 74, Mich. P.A. 1970

05-175

Alger
(County)

Located In:

Corner Code #

- 1. Public Land Survey

T	48N	R	15W	L1
T	49N	R	15W	L13 ✓
T		R		
T		R		
- 2. Property Controlling in Section

S		T		R	
S		T		R	
- 3. Miscellaneous Property in Section

S		T		R	
S		T		R	
- 4. Lot No. _____, Recorded Plat _____
- 5. Private Claims _____

FILED
TIME 1:32 pm

DEC 15 1999

DONALD W. KINNUNEN
REGISTER OF DEEDS
ALGER COUNTY, MI
Register of Deeds Stamp & File Number

I, Robert L. Jamros, in a field survey on October 20, 1999, 19_____, do hereby state that under requirements of P.A. 74, Michigan P.A. of 1970, the corner points mentioned in lines 1 and 2 above were in conformance with regulations and rules therefore as required in the current manual of survey instructions of the United States Department of the Interior, Bureau of Land Management or by a decree of a Court of Law and/or that the corner points mentioned in lines 3, 4 and 5 above were in conformance with the rules of the Michigan Board of Land Surveyors or by a Decree of a Court of Law; established, re-established, monumented, _____ recovered, found as expressed below:

A	B	C	D	E	F	G	H	I	J	K	L	M
2	6	5	4	3	2	1						
3												
4	7	8	9	10	11	12						
5												
6	18	17	16	15	14	13						
7												
8	19	20	21	22	23	24						
9												
10	30	29	28	27	26	25						
11												
12	31	32	33	34	35	36						
13												

NOTE: Not more than 2 corners, all in the same town and range, may be recorded on this certificate.

A. Description of original monument and accessories and/or subsequent restoration:


L1: PLS * John Burt, DS, 1841. * Set quarter section post. * Beech 22", N.39 E., 05 links. * Beech 12", N.20 W., 14 links. **** No other subsequent restoration of record.

B. Description of corner evidence found and/or method applied in restoring or reestablishing corner:

L1: Located corner search area by calculated position and standard field survey methods. No GLO evidence of the corner position or the BT's remain, position has been lost. Reestablished corner position at the mid point and on line between section corners 1/2 mile East and 1/2 mile West. Corner position as reestablished is accepted as a careful and faithful reestablishment of the position of the original corner.

C. Description of monument for corner and accessories established to perpetuate locating the position of the corner:

L1: Set 2 1/2"x30" Berntsen aluminum monument No. A1NB30 with 3 1/4" aluminum cap stamped to identify corner position. * Established the following reference trees with BT signs, blazed, scribed and painted. * Set PK nails with aluminum I.O. washers for measure in the following: Beech 7", N.58 E., 18.22 feet, '1/4s BT'. * Beech 6", S.21 E., 20.91 feet, '1/4s BT'. * Beech 7", S.58 W., 30.76 feet, '1/4s BT'. * Maple 9", N.67 W., 16.27 feet, '1/4s BT'. * Survey marker sign on 6 foot steel post, S.41 E., 1.5 feet. * All bearings are magnetic.

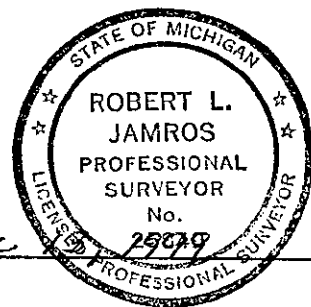

Signed by *Robert L. Jamros* Date Dec
Surveyor's Michigan License No. 25849