

Approved by Alger County
 Land Survey Monumentation
 Peer Group Under Act 245 of
 P.A. of 1935 On 3-24-1997

Gerald Carlson
 Chairman

LAND CORNER RECORDATION CERTIFICATE
 Filing Requirement of Act 74, Mich. P.A. 1970

5-27


For corners in ALGER Located in: _____ Corner Code # _____
 (County)

- | | | | | | |
|--------------------------------------|---|------------|---|------------|-----------|
| 1. Public Land Survey | T | 49N | R | 13W | A3 |
| | T | <u>49N</u> | R | <u>14W</u> | <u>M3</u> |
| | T | _____ | R | _____ | _____ |
| | T | _____ | R | _____ | _____ |
| 2. Property Controlling in Section | S | _____ | T | _____ | R |
| | S | _____ | T | _____ | R |
| 3. Miscellaneous Property in Section | S | _____ | T | _____ | R |
| | S | _____ | T | _____ | R |

FILED
 TIME 2:00 pm.
 MAR 31 1997
 DONALD W. KINNUNEN
 REGISTER OF DEEDS
 ALGER COUNTY, MI
 Register of Deeds Stamp & File Number

4. Lot No. _____, Recorded Plat _____
 5. Private Claims _____

I, Robert L. Jamros, in a field survey on October 08, 1996, 19_____, do hereby certify that under requirements of P.A. 74, Michigan P.A. of 1970, the corner points mentioned in lines 1 and 2 above were in conformance with regulations and rules therefore as required in the current manual of survey instructions of the United States Department of the Interior, Bureau of Land Management or by a decree of a Court of Law and/or that the corner points mentioned in lines 3, 4 and 5 above were in conformance with the rules of the Michigan Board of Professional Surveyors or by a Decree of a Court of Law; established, re-established, monumented, re-monumented, recovered, found as expressed below:

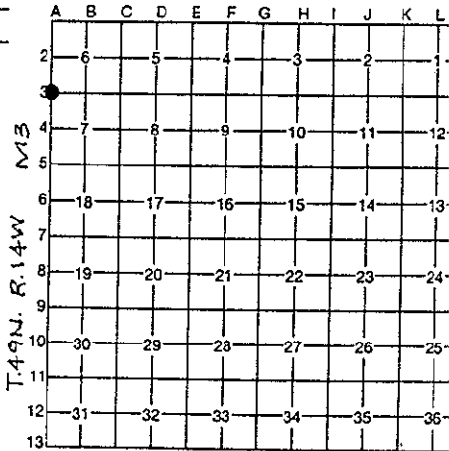


NOTE: Not more than 4 corners, all in the same town and range, may be recorded on this certificate.

A. Description of original monument and accessories and/or subsequent restoration:
 A3: PLS - John Burt, DS, for William A. Burt, DS, 1841, Set post corner of Sections 1 & 12, T.49N., R.13W. * Sugar 12, S.70 W., 34 links * Beech 5, N.37 E., 26 links. * Geo. E. Adair, DS, 1851. * Post, Y. Birch 15, N.71 W., 33 links. * Beech 12, S.72 E., 24 links. **** James Roundtree, CS, 1908. * Iron Post driven according to field notes and barren trees in cut in county road, 1 1/4" in diam. and 26' long. * References, 9" Cedar post, SE, 69 links. **** M.S.H.D., Project No. DS 610(3) 1958. * 1 1/2" iron pipe 1.37 feet East of survey centerline. * References, P. Pole, S.32 E. 48.80 feet, * Guy Pole, S.53 W., 45.40 feet, * 5" Beech, N.62 E., 65.05. **** M Davis, RLS, 1971. * Monument box in highway, apparently set by the Michigan State Highway Dept. * Witness, Centerline of Elec. Pole, S.E., 44.20 feet. * Centerline of Guy pole, S.W., 48.30 feet. * Centerline of Highway M-77, West, 0.90 feet. * Recorded in L.1, P.1, Alger County Records. **** Gerald W. Carlson, RLS, 1977. * Found 1 1/4" pipe in monument box in centerline of M-77 and centerline of E-W gravel road. * References, P.P., S.38 E., 48.17'. * S.P., N.30 E., 52.64'. * T.P., S.55 W., 44.23'. * T.P., S.33 W., 61.75'. * Recorded in L.1, P.113, Alger County Records.

B. Description of corner evidence found and/or method applied in restoring or reestablishing corner:
 A3: Found 1 1/2" iron pipe in monument box 1 foot East of centerline of pavement on State Highway M-77, centerline of gravel road west and 4 feet North of centerline gravel road East. Measurements to corners North and South as part of a Section Subdivision check well. References of 1958 and 1971 report not found. Established new references. Monument at existing corner position is accepted as a careful and faithful perpetuation of the position of the original corner.

C. Description of monument for corner and accessories established to perpetuate locating the position of the corner:
 A3: Installed 5/8" X 18" Rebar w/ 3 1/4" Aluminum Cap inside of existing 1 1/2" pipe, stamped to identify corner position. Corner position lies within the improved area of the Village of Grand Marais and along the M-77 corridor. Used only PK nails for measure w/ Alum. I.D. washers in the following reference objects: * W. Birch 6", N.44 W., 68.45 feet. * Guy Pole, S.57 W., 44.22 feet. * Guy Pole N.45 E., 58.33 feet. * Power Pole with overhead, S.34 E., 48.20 feet. * All bearings are magnetic.

Signed by Robert L. Jamros
 Surveyor's Michigan License No. 25849

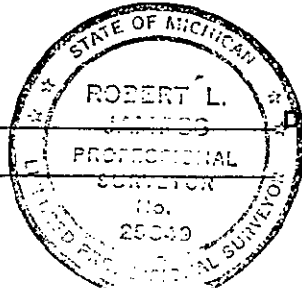

Date 25 March, 1997