

Approved by Alger County
Land Survey Reorganization
Peer Group Under Act 343 of
P.A. of 1990 On 3-24-1997

Gerald Carlson
Chairman

LAND CORNER RECORDATION CERTIFICATE
Filing Requirement of Act 74, Mich. P.A. 1970

5-26


For corners in ALGER Located In: _____ Corner Code # _____
(County)

- | | | | | | |
|--------------------------------------|---|-----|---|-----|----|
| 1. Public Land Survey | T | 49N | R | 13W | A4 |
| | T | 49N | R | 14W | M4 |
| | T | | R | | |
| | T | | R | | |
| 2. Property Controlling in Section | S | | T | | R |
| | S | | T | | R |
| 3. Miscellaneous Property in Section | S | | T | | R |
| | S | | T | | R |

FILED
TIME 2:00 pm
MAR 31 1997
DONALD W. KINNUNEN
REGISTER OF DEEDS
ALGER COUNTY, MI
Register of Deeds Stamp & File Number

4. Lot No. _____, Recorded Plat _____
5. Private Claims _____

I, Robert L. Jamros, in a field survey on October 07, 1996, 19_____, do hereby certify that under requirements of P.A. 74, Michigan P.A. of 1970, the corner points mentioned in lines 1 and 2 above were in conformance with regulations and rules therefore as required in the current manual of survey instructions of the United States Department of the Interior, Bureau of Land Management or by a decree of a Court of Law and/or that the corner points mentioned in lines 3, 4 and 5 above were in conformance with the rules of the Michigan Board of Professional Surveyors or by a Decree of a Court of Law; established, re-established, monumented, re-monumented, recovered, found as expressed below:

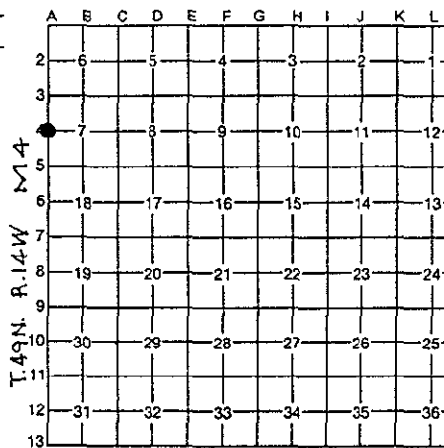

NOTE: Not more than 4 corners, all in the same town and range, may be recorded on this certificate.

A. Description of original monument and accessories and/or subsequent restoration:

A4: PLS - John Burt, DS, for William A. Burt, DS, 1841, Cedar 15, Quarter Section Corner * Cedar 14, S.62 E., 16 links **** M.S.H.D. Project No. DS 610(3), 1958. * No corner position shown on construction plans. **** Gerald W. Carlson, RLS, 1978. * Set PK nail in asphalt equid. on East side of M-77 and on South side of E-W gravel road. * References, T.P., S.59 W., 41.57 feet, * T.P. N.41 W. 48. feet, * P. Pole, N.32 E., 38.68 feet, * SW corner stop sign, N.76 E., 46.60 feet. Recorded in L.1, P.113, Alger County Records. **** Neil E. Hill, RLS, 1990. * Found PK nail in East line of M-77. * Replaced found nail with 1/2" rerod and cap #27447 in monument box. References, S.59 W., 41.59 feet, Found nail in T.P. * N.41 W., 48.34 feet, MDOT tag in T.P. * N.32 E., 38.70 feet, Found nail in P.P. N.76 E., 46.60 feet, SW corner stop sign. * N.67 E., 45.77 feet, MDOT tag in wood post #772.


B. Description of corner evidence found and/or method applied in restoring or reestablishing corner:

A4: Found 1/2" Rebar w/ MDOT cap No. 27447 in monument box 9 feet East of the centerline of pavement of State Highway M-77 and 5.5 feet South of centerline of East-West gravel road. * Replaced 1/2" Rebar with 5/8" X 18" Rebar w/ 3 1/4" Aluminum Cap stamped to identify corner position. Renewed existing reference objects and added additional references. Monument at existing corner position is accept as a careful and faithful reestablishment of the position of the original corner.

C. Description of monument for corner and accessories established to perpetuate locating the position of the corner:

A4: Set 5/8" X 18" Rebar w/ 3 1/4" Aluminum Cap stamped to identify corner position. * Corner position lies within the improved area the Village of Grand Marais and along the M-77 corridor. * Used only PK nails for measure w/ Alum. I.D. washers in the following reference trees. * W. Ash 5", S.51 W., 72.42 feet. * Chiseled "X" in top of concrete culvert flare, N.46 W., 48.48 feet. * W. Birch 5 S.25 E., 68.56 feet. * Exit. BT, Power Pole, N.35 E., 38.68 feet. * All bearings are magnetic.

Signed by Robert L. Jamros
Surveyor's Michigan License No. 25849

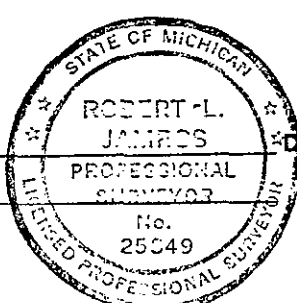

Date 25 March, 1997
FORM APPROVED BY MICHIGAN STATE BOARD OF PROFESSIONAL SURVEYORS, JAN. 28, 1971
REVISED MAY 14, 1975
REVISED JAN. 1983