

Approved by Alger County  
Land Survey Monumentation  
Board Group Under Act 345 of  
P.A. of 1990 On 3-24-1997

Gerald Carlson  
Chairman

**LAND CORNER RECORDATION CERTIFICATE**  
Filing Requirement of Act 74, Mich. P.A. 1970

5-28

For corners in ALGER Located In: \_\_\_\_\_ Corner Code # \_\_\_\_\_  
(County)

1. Public Land Survey	T	49N	R	13W	A5
	T	49N	R	14W	M5
	T		R		
	T		R		
2. Property Controlling in Section	S		T	R	
	S		T	R	
3. Miscellaneous Property in Section	S		T	R	
	S		T	R	

FILED  
TIME 2:00 PM

MAR 31 1997

DONALD W. KINNUNEN  
REGISTER OF DEEDS  
ALGER COUNTY, MI

Register of Deeds Stamp & File Number

4. Lot No. \_\_\_\_\_, Recorded Plat \_\_\_\_\_  
5. Private Claims \_\_\_\_\_

	A	B	C	D	E	F	G	H	I	J	K	L
2	6	5										
3												
4	7	8	9	10	11	12						
5												
6	18	17	16	15	14	13						
7												
8	19	20	21	22	23	24						
9												
10	30	29	28	27	26	25						
11												
12	31	32	33	34	35	36						
13												

I, Robert L. Jamros, in a field survey on October 07, 1996, 19\_\_\_\_\_, do hereby certify that under requirements of P.A. 74, Michigan P.A. of 1970, the corner points mentioned in lines 1 and 2 above were in conformance with regulations and rules therefore as required in the current manual of survey instructions of the United States Department of the Interior, Bureau of Land Management or by a decree of a Court of Law and/or that the corner points mentioned in lines 3, 4 and 5 above were in conformance with the rules of the Michigan Board of Professional Surveyors or by a Decree of a Court of Law; established, re-established, monumented, re-monumented, recovered, found as expressed below:

**NOTE: Not more than 4 corners, all in the same town and range, may be recorded on this certificate.**

**A. Description of original monument and accessories and/or subsequent restoration:**

A5: PLS - John Burt, DS, for William A. Burt, DS, 1841, Set post corner of Sections 12 & 13, T.49N., R.13W. \* Spruce 12, S.24 W., 24 lks \* Cedar 12, N.10 E., 24 lks. \* Geo. E. Adair, DS, 1851. \* Post, Cedar 20, N.05 W., 34 lks. \* Cedar 14, S.60 E., 47 lks. \*\*\*\* Geo. L. Depew, CS, Dec. 1917. \* Placed S.E. cor. of Sec. 12, T.49N., R.14W. \* RP fen. cor. N.55 W., 49 ft. \* Cor. in dit. line of N-S road 15 ft. from center of road. \*\*\*\* Alger County Road Commission, Edwin Swan, R.L.S., 1949. \* 1 1/4" cor. axle. \* Tel. Pole, S.47 W., 37.4 ft. \* Cor. fen. post, S.38 E., 39.4 ft; \*\*\*\* M.S.H.D., Proj. No. DS 610(3), 1958. \* Sta. 768+71.45, 1 1/4" iron pipe. \* P. Pole, N.22 E., 36.37 ft. \* Guy Pole, N.53 W., 63.81 ft. \* T. Pole, S.60 W., 48.03 ft. \*\*\*\* Mel Davis, RLS, 1971. \* Mon. box in hwy., apparently set by the Mich. State Hwy. Dept. \* Wit., USGS Bench Mark tablet in conc., N.65 W., 71.70 ft. \* CL Elec. Pole, N.22 E., 35.80 ft. \* CL Tele. Pole, S.61 W., 52.00 ft. \* CL of State Hwy. M-77, W., 16.70 ft. \* Recorded in L.1, P.4, Alger Co. Records. \*\*\*\* Gerald W. Carlson, RLS, 1977. \* Fd. sq. top spike in mon. box E. side of M-77, CL of E-W grav. road. \* Wit., P.P., N.24 E., 35.86'. \* T.P., S.73 E., 81.60'. \* T.P., S.63 W., 51.98'. \* T.P., N.53 W., 63.47'. \* Recorded in L.1, P.113, Alger Co. Records.


**B. Description of corner evidence found and/or method applied in restoring or reestablishing corner:**

A5: Found Boat spike in Monument box 19.6 feet East of the centerline of State Highway M-77 pavement and 3 feet South of centerline of East-West gravel road. \* Replaced Boat spike w/ 5/8" X 18" Rebar w/ 3 1/4" Aluminum Cap stamped to identify corner position. Renewed existing references and objects. Monument at existing corner position is accepted as the best available evidence of the position of the original corner.

**C. Description of monument for corner and accessories established to perpetuate locating the position of the corner:**

A5: Set 5/8" X 18" Rebar w/ 3 1/4" Aluminum Cap stamped to identify corner position. \* Corner position lies within the improved area of the Village of Grand Marais and along the M-77 corridor. \* Used only PKnails for measure w/ Alum. I.D. washers in the following reference objects. \* Maple 14", S.72.W., 91.97 feet. \* Service Pole, N.50 W., 63.53 feet. \* Transformer Pole, N.25 E., 35.78 feet. \* Power Pole w/ Underground, S.64 E., 81.65 feet. \* All bearings are magnetic.

Signed by Robert L. Jamros  
Surveyor's Michigan License No. 25849

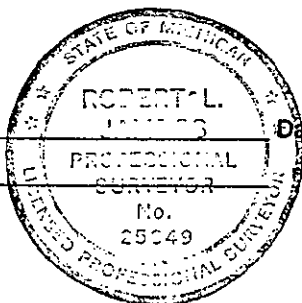

Date 25 March, 1997