# LAND CORNER RECORDATION CERTIFICATE

**Filing Requirement of Act 74, Mich. P.A. 1970 as Amended**

For corners in

Alger (County) Located In: Corner Code #

1. Public Land Survey T R
   T R
   T R

2. Property Controlling in Section
   S 25 T 49N R 16W N-N 1/64
   S 25 T 49N R 16W 14
   S T R

3. Miscellaneous Property in Sec.
   S T R
   S T R

4. Lot No. _____, Recorded Plat _____

5. Private Claims

Register of Deeds Stamp & File Number

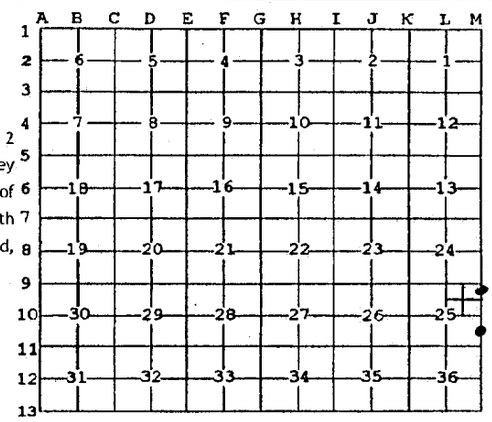


I, Stephan J. Szyszkoski, in a field survey on N-N 1/64 04/08/2009 14 06/03/2009 do hereby state that under requirements of P.A. 74, Michigan P.A. of 1970, the corner points mentioned in lines 1 and 2 above were in conformance with regulations and rules therefore as required in the current manual of survey instructions of the United States Department of the Interior, Bureau of Land Management or by a decree of a Court of Law and /or that the corner points mentioned in lines 3, 4 and 5 above were in conformance with the rules of the Michigan Board of Land Surveyors or by a Decree of a Court of Law; established, re-established, monumented, recovered, found as expressed below:

**NOTE: Not more than 2 corners, all in the same town and range, may be recorded on this certificate.**

A. Description of original monument and accessories and/or subsequent restoration:

(N-N 1/64 between Sec. 25 and 30) 1/64 corner South of M9, being the SE corner of the NE1/4 of the NE1/4 of the NE1/4 of Section 25, T49N-R16W and the SW corner of the NW1/4 of the NW1/4 of the NW1/4 of Section 30, T49N-R15W. Not established in the original survey.

(14-Sec. 25) South 1/16 corner between Section 25 T49N-R16W and Section 30 T49N-R15W. Not established in the original survey.

B. Description of corner evidence found and/or method applied in restoring or reestablishing corner:

(N-N 1/64) Established the corner midway and on the Section line between Section corner M9 660.88' north and 1/16 corner #7, Sec. 25, 660.88' south.

(14-Sec. 25) Established the corner midway and on the Range line between Section corner 1321.75' south and Quarter corner 1321.75' north.

C. Description of monument for corner and accessories established to perpetuate locating the position of the corner:

(1/64) Set 1"IDx36" I.pipe with 4" alum. MDNR cap.
Set measuring nail with MDNR tag in the side of:
10" R.Pine S73E 15.0' mrkd "1/64 BT"
12" W.Pine N03W 17.72' do
6" W.Pine N36W 17.62' do
10" W.Birch S32W 20.48' do
Bearings are magnetic.

(14) Set 1"IDx36" I.pipe with 4" alum. MDNR cap.
Set measuring nail with MDNR tag in the side of:
10" Maple S69E 4.85' mrkd "S1/16 BT"
4" W.Pine S55W 22.46' do
8" W.Birch N60E 24.66' do
9" W.Birch N04W 51.32' do
Bearings are magnetic.

Signed by Stephan J. Szyszkoski Date 08/10/2009

Surveyor's Michigan License No. 33986

STATE OF MICHIGAN STEPHAN J. SZYSZKOSKI LAND SURVEYOR No. 33986 LICENSED LAND SURVEYOR

For the Michigan Department of Natural Resources, Office of Land and Facilities

47251

47243

FORM APPROVED BY MICHIGAN STATE BOARD OF PROFESSIONAL SURVEYORS, JUNE 16, 1971
Revised May 14, 1975
Revised Jan., 1983
Revised Oct., 1995