

ALLEGAN COUNTY REMONUMENTATION
LAND CORNER RECORDATION CERTIFICATE

Filing Requirement of Act 74, Mich. P.A. 1970

For corners in **COMMISSION**

<u>ALLEGAN</u> (County)	Located in:	Corner Code #
1. Public Land Survey	T <u>1</u> N R <u>11</u> W	<u>A-7 (SW, 18)</u>
	T ___ R ___	<u>Gun Plain</u>
	T ___ R ___	_____
	T ___ R ___	_____
2. Property Controlling in Section	S ___ T ___ R ___	_____
	S ___ T ___ R ___	_____
3. Miscellaneous Property in Sec.	S ___ T ___ R ___	_____
	S ___ T ___ R ___	_____

1993 DEC 30 PM 2:44
REGISTER OF DEEDS
ALLEGAN COUNTY, MICH.
Register of Deeds Stamp & File Number

FILED

4. Lot No. _____, Recorded Plat _____
5. Private Claims _____

I, David F. Peabody, in a field survey on October, 1993, do hereby certify that under requirements of P.A. 74, Michigan P.A. of 1970, the corner points mentioned in lines 1 and 2 above were in conformance with regulations and rules therefore as required in the current manual of survey instructions of the United States Department of the Interior, Bureau of Land Management or by a decree of a Court of Law and/or that the corner points mentioned in lines 3, 4 and 5 above were in conformance with the rules of the Michigan Board of Land Surveyors or by a Decree of a Court of Law: established, re-established, monumented, re-monumented, recovered, found as expressed below:

	A	B	C	D	E	F	G	H	I	J	K	L	M
2	6	5	4	3	2	1							
3													
4	7	8	9	10	11	12							
5													
6	13	17	16	15	14	13							
7													
8	19	20	21	22	23	24							
9													
10	30	29	28	27	26	25							
11													
12	31	32	33	34	35	36							
13													


NOTE: Not more than 4 corners, all in the same town and range, may be recorded on this certificate.

A. Description of original monument and accessories and/or subsequent restoration:

G.L.O.	Donald Ratekin 1971 LCRC L.1, P.62
W. Oak 11 S51E 34	Iron Pipe
DO. 12 N28E 37	Power Pole South 67.6'
	1 1/2" Sycamore S50°W 64.8'
	14" Walnut N70°W 64.5'
	Centerline 106th Avenue N. 10'
MSHD (1956) 1 1/2" Pipe	
18" Walnut N02°E 35.24'	
11" Walnut N56°W 65.18'	
36" Maple S76°E 100.21'	

B. Description of corner evidence found and/or method applied in restoring or reestablishing corner:

G.L.O. All Gone
11" Walnut N56°W 65.18'
Power Pole South 67.6'
Centerline 106th Avenue N. 10'
Found 1" Pipe W/1/2" iron in center
This Corner is accepted as a careful and faithful reestablishment of the position of the Original Corner.

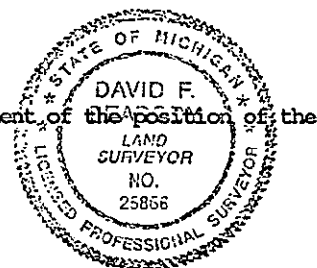

C. Description of monument for corner and accessories established to perpetuate locating the position of the corner:

Placed 3/4" iron W/Remon Cap 0.15' E. of Existing Pipe On Straight Line From M-6 to M-7 (Otsego Twp.)

20d Nail W/Allegan Co. Tag W. Side Power Pole S. 67.94'
iron Pipe in C.L. 106th Ave. N. 10.16'
20d Nail W/Allegan Co. Tag NE Side 12" Walnut S35°E 64.70'
20d Nail W/Allegan Co. Tag E. Side 12" Oak S10°E 90.85'
1" iron South 33.00'

Signed by David F. Peabody Date 12/20/93
Surveyor's Michigan License No. 25866