

SURVEY & REMONUMENTATION

APR 29 1996

ALLEGAN COUNTY REMONUMENTATION
LAND CORNER RECORDATION CERTIFICATE

COMMISSION Filing Requirement of Act 74, Mich. P.A. 1970

For corners in

| | | |
|---|--------------------------|--------------------------|
| <u>Allegan</u> <small>(County)</small> | Located In: | Corner Code -## |
| 1. Public Land Survey | T <u>1</u> N <u>11</u> W | D-1 (N ¹ , 5) |
| | T _____ R _____ | Gun Plain _____ |
| | T _____ R _____ | _____ |
| | T _____ R _____ | _____ |
| 2. Property Controlling in Section | S _____ T _____ R _____ | _____ |
| | S _____ T _____ R _____ | _____ |
| 3. Miscellaneous Property in Sec. | S _____ T _____ R _____ | _____ |
| | S _____ T _____ R _____ | _____ |

REGISTER OF DEEDS
ALLEGAN COUNTY, MICHIGAN

1995 APR 24 PM 2:20

FILED

Register of Deeds Stamp & File Number

4. Lot No. _____, Recorded Plat _____
5. Private Claims _____

| | | | | | | | | | | | | | |
|----|----|----|----|----|----|----|---|---|---|---|---|---|---|
| | A | B | C | D | E | F | G | H | I | J | K | L | M |
| 2 | 6 | 5 | 4 | 3 | 2 | 1 | | | | | | | |
| 3 | | | | | | | | | | | | | |
| 4 | 7 | 8 | 9 | 10 | 11 | 12 | | | | | | | |
| 5 | | | | | | | | | | | | | |
| 6 | 18 | 17 | 16 | 15 | 14 | 13 | | | | | | | |
| 7 | | | | | | | | | | | | | |
| 8 | 19 | 20 | 21 | 22 | 23 | 24 | | | | | | | |
| 9 | | | | | | | | | | | | | |
| 10 | 30 | 29 | 28 | 27 | 26 | 25 | | | | | | | |
| 11 | | | | | | | | | | | | | |
| 12 | 31 | 32 | 33 | 34 | 35 | 36 | | | | | | | |
| 13 | | | | | | | | | | | | | |

I, David F. Peabody, in a field survey on November 10, 1994, do hereby certify that under requirements of P.A. 74, Michigan P.A. of 1970, the corner points mentioned in lines 1 and 2 above were in conformance with regulations and rules therefore as required in the current manual of survey instructions of the United States Department of the Interior, Bureau of Land Management or by a decree of a Court of Law and/or that the corner points mentioned in lines 3, 4 and 5 above were in conformance with the rules of the Michigan Board of Land Surveyors or by a Decree of a Court of Law; established, re-established, monumented, re-monumented, recovered, found as expressed below:

NOTE: Not more than 4 corners, all in the same town and range, may be recorded on this certificate.

A. Description of original monument and accessories and/or subsequent restoration:


G.L.O. (corner not set)
No other witness

APPROVED REMONUMENTATION CORNER
P.A. 345 OF 1990
ALLEGAN COUNTY
DATE APPROVED 11-8-94
COUNTY REP. David F. Peabody

B. Description of corner evidence found and/or method applied in restoring or reestablishing corner:

Set 3/4" Iron W/Remon Cap by splitting distance from C-1 to E-1 and on Township Line from D-13 (Martin Twp.) to C-13 (Martin Twp.)


This position not established by original government surveyors. This monument is accepted as the best available evidence of the position of the corner.

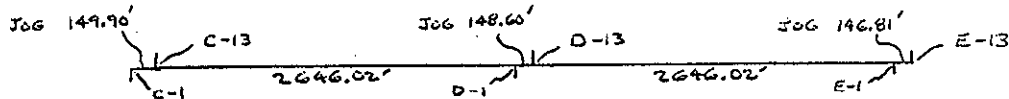

Peer Group Approved 11-08-94

C. Description of monument for corner and accessories established to perpetuate locating the position of the corner:

- Set 3/4" Iron W/Remon Cap
- 20d Nail W/Allegan Co. Tag SE Side 34" Maple S50°W 46.42'
- 20d Nail W/Allegan Co. Tag W. Side 14" Maple S10°E 27.18'
- 20d Nail W/Allegan Co. Tag W. Side 15" Locust N40°W 27.66'
- 3/8" Iron W/mushed cap West 29.68'
- S1/4 Cor. Sec. 32 (Martin Twp.) D-13 East 148.60'
- C/L Rd. North 2'±

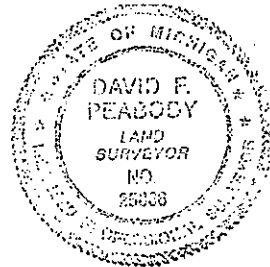

FILED 0005 PAGE 172

Signed by David F. Peabody Date 1/26/95
Surveyor's Michigan License No. 25866