

LAND CORNER RECORDATION CERTIFICATE
Filing Requirement of Act 74, Mich. P.A. 1970

For corners in
Allegan
(County)

Located In: _____ Corner Code ##

1. Public Land Survey	T	N	R	12W	L-7
	T	N	R	12W	L-9
	T		R		
	T		R		
2. Property Controlling in Section	S		T	R	
	S		T	R	
3. Miscellaneous Property in Sec.	S		T	R	
	S		T	R	

Register of Deeds Stamp & File Number

4. Lot No. _____, Recorded Plat _____
 5. Private Claims _____

	A	B	C	D	E	F	G	H	I	J	K	L	M
2	6		5		4		3		2		1		
3													
4	7		8		9		10		11		12		
5													
6	18		17		16		15		14		13		
7													
8	19		20		21		22		23		24		
9													
10	30		29		28		27		26		25		
11													
12	31		32		33		34		35		36		
13													

Gary C. Bilow March 6 1990

I, _____, in a field survey on _____, 19____ do hereby certify that under requirements of P.A. 74, Michigan P.A. of 1970, the corner points mentioned in lines 1 and 2 above were in conformance with regulations and rules therefore as required in the current manual of survey instructions of the United States Department of the Interior, Bureau of Land Management or by a decree of a Court of Law and/or that the corner points mentioned in lines 3, 4 and 5 above were in conformance with the rules of the Michigan Board of Land Surveyors or by a Decree of a Court of Law, established, re-established, monumented, re-monumented, recovered, found as expressed below:

NOTE: Not more than 4 corners, all in the same town and range, may be recorded on this certificate.

A. Description of original monument and accessories and/or subsequent restoration:

(L-7) Corner recorded by Donald A. Ratekin, RLS 8781, January, 1974 as found 3/4" iron. Accessories noted on L.C.R.C. L.1 - P. 249

(L-9) Corner recorded by Donald A. Ratekin, RLS 8781, July, 1971 as found 1/2" iron in monument box. Accessories noted on L.C.R.C. L.1 - P.66

B. Description of corner evidence found and/or method applied in restoring or reestablishing corner:

(L-7) Found and accepted 3/4" iron bar flush with ground. Ratekin accessories to Oaks check.


(L-9) Found and accepted 1/2" iron in monument box. Ratekin's accessories obliterated but position checks well with angular measurements shown on surveys Rec L.941 - P.24 and L. 987 - P.586 and with distance measurement north to the monumented SE corner of parcel B of survey Rec. L. 1023 - P.526

C. Description of monument for corner and accessories established to perpetuate locating the position of the corner:

(L-7) Found 3/4" iron bar
 South 99.8' North edge of north rail of railroad
 N70°W 12.03' Set nail and MDNR tag NE face 18" Oak
 S8°E 4.26' Set nail and MDNR tag NW face Cherry
 N5°W 50.48' Set nail and MDNR tag in E'ly Face 20" Oak

(L-9) Found 1/2" iron in monument box
 North 50.01' 4" dia. concrete monument with MDNR cap
 S38°E 64.70' Found iron with cap #26463
 S48°W 102.2' NE Cor. of N. Square Steel post of Oaks crossing shopping center sign
 N09°W 66.5' SE Cor. of Square Steel post of Conchica Bank sign

Signed by Gary C. Bilow
 Surveyor's Michigan License No. 26453

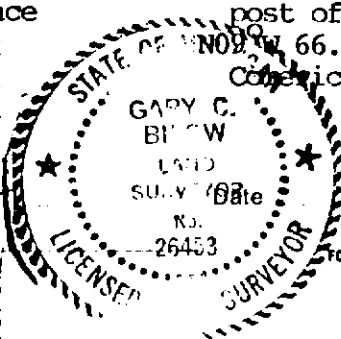

11/16/90