

**LAND CORNER RECORDATION CERTIFICATE**  
**Filing Requirement of Act 74, Mich. P.A. 1970**

For corners in

<u>Allegan</u> <small>(County)</small>	Located In:	Corner Code <u>##</u>
1. Public Land Survey	T <u>1N</u> R <u>12W</u>	<u>E-9</u>
	T <u>1N</u> R <u>12W</u>	<u>C-9</u>
	T _____ R _____	_____
	T _____ R _____	_____
2. Property Controlling in Section	S _____ T _____ R _____	_____
	S _____ T _____ R _____	_____
3. Miscellaneous Property in Sec.	S _____ T _____ R _____	_____
	S _____ T _____ R _____	_____

Register of Deeds Stamp & File Number

4. Lot No. \_\_\_\_\_, Recorded Plat \_\_\_\_\_  
 5. Private Claims \_\_\_\_\_

I, Gary C. Bilow, in a field survey on May 23, 1990, do hereby certify that under requirements of P.A. 74, Michigan P.A. of 1970, the corner points mentioned in lines 1 and 2 above were in conformance with regulations and rules therefore as required in the current manual of survey instructions of the United States Department of the Interior, Bureau of Land Management or by a decree of a Court of Law and/or that the corner points mentioned in lines 3, 4 and 5 above were in conformance with the rules of the Michigan Board of Land Surveyors or by a Decree of a Court of Law, established, re-established, monumented, re-monumented, recovered, found as expressed below:

**NOTE: Not more than 4 corners, all in the same town and range, may be recorded on this certificate.**

A	B	C	D	E	F	G	H	I	J	K	L	M
2	6	5	4	3	2							
3												
4	7	8	9	10	11	12						
5												
6	16	17	18	15	14	13						
7												
8	19	20	21	22	23	24						
9												
10	30	29	28	27	26	25						
11												
12	31	32	33	34	35	36						
13												

A. Description of original monument and accessories and/or subsequent restoration:

(E-9) Corner recorded by D.A. Ratekin Sept. 1974 as found 4" well point. See accessories as noted on L.C.R.C. L.2 - P. 326.

(C-9) Corner recorded by D.A. Ratekin Oct. 1971 as found 2" pipe if no corner post encased with rock. See accessories as noted on L.C.R.C. L.1 - P. 107.

B. Description of corner evidence found and/or method applied in restoring or reestablishing corner:


(E-9) Well point apparently removed by recent earthwork. Found and accepted 8" dia. stone, set vertically below ground surface with chiseled "+" on top at corner position. Ratekin accessories to nail in Maple, west, and to iron, east, check.

(C-9) Found and accepted 2" pipe fence corner. Corner falls in intersection of tree row North, South and West. Ratekin ties check. This corner is being re-recorded to update accessories.

C. Description of monument for corner and accessories established to perpetuate locating the position of the corner:

(E-9) Found 8" dia. stone with "+" on top. West 13.54', Fd. nail and added spike with MDNR tag in 12" Maple. S82°E 113.62' set spike and MDNR tag in transformer pole. S10°W 46.80' set spike and MDNR tag E face 9" Elm. S43°W 55.88' set spike and MDNR tag SE face 7" Elm. East 306.94' found iron bar.

(C-9) Found 2" dia. iron pipe fence cor. West 8.06' set spike and MDNR tag in osage orange clump. S40°W 9.55' set spike and MDNR tag in Walnut. S05°W 37.0' Walnut.

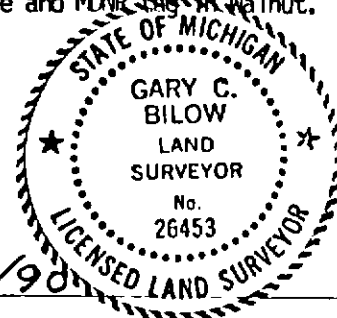

Signed by Gary C. Bilow  
 Surveyor's Michigan License No. 26453

Date 8/28/90