

**LAND CORNER RECORDATION CERTIFICATE**  
**Filing Requirement of Act 74, Mich. P.A. 1970**

For corners in

Allegan

(County)

Located In:

Corner Code #

1. Public Land Survey	T	1N	R	12W	D-6
	T	1N	R	12W	E-6
	T		R		
	T		R		
	T		R		
2. Property Controlling in Section	S		T	R	
	S		T	R	
3. Miscellaneous Property in Sec.	S		T	R	
	S		T	R	

Register of Deeds Stamp & File Number

4. Lot No. \_\_\_\_\_, Recorded Plat \_\_\_\_\_  
 5. Private Claims \_\_\_\_\_

I, Gary C. Bilow, in a field survey on March 29, 1990

do hereby certify that under requirements of P.A. 74, Michigan P.A. of 1970, the corner points mentioned in lines 1 and 2 above were in conformance with regulations and rules therefore as required in the current manual of survey instructions of the United States Department of the Interior, Bureau of Land Management or by a decree of a Court of Law and/or that the corner points mentioned in lines 3, 4 and 5 above were in conformance with the rules of the Michigan Board of Land Surveyors or by a Decree of a Court of Law; established, re-established, monumented, re-monumented, recovered, found as expressed below:

**NOTE: Not more than 4 corners, all in the same town and range, may be recorded on this certificate.**

A	B	C	D	E	F	G	H	I	J	K	L	M
2	6	5	4	3	2							
3												
4	7	8	9	10	11	12						
5												
11												
12	31	32	33	34	35	36						
13												

A. Description of original monument and accessories and/or subsequent restoration:

(D-6) Corner not set in original survey  
 Recorded by D. A. Ratekin, RLS 8781 in L.1,  
 P. 106 as found 1" iron pipe Rec.  
 Accessories:  
 RR Tie Fence Post N. 0.8'  
 30" Maple West 12.8'  
 20" Oak N20°W 29.3'  
 10" Oak N20°E 23.0'

(E-6) Corner recorded by D. A. Ratekin  
 L.1, P. 106 as found 1" iron. Rec.  
 Accessories:  
 15" Oak S20°W 7.3'  
 30" Oak North 25.3'  
 14" Sassafrass East 22.3'

B. Description of corner evidence found and/or method applied in restoring or reestablishing corner:

(D-6) Found 1" Iron bar 8.5' W. and 7.5' N of intersection of straight lines connecting opposite 1/4 corners. Ratekin accessories to post and 10" Oak check. Others are destroyed.

(E-6) Found 1" iron bar at intersection of fence and tree row. Ratekin accessories to 30" Oak and Sassafrass check


C. Description of monument for corner and accessories established to perpetuate locating the position of the corner:

(D-6) Found 1" Iron Pipe  
 North 0.8' RR Tie Fence Post  
 N20°E 23.0' 10" Oak  
 S85°W 13.12' Set nail and MDNR  
 Tag in 27" Maple  
 N15°W 30.05, Set Nail and MDNR  
 Tag in 23" Oak  
 S25°W 34.58', Set Nail and MDNR  
 Tag in 18" Oak

(E-6) Found 1" Iron  
 East 22.3' 14" Sassafrass  
 S27°W 8.35' Set nail and MDNR tag in  
 20" Oak  
 North 26.13' Set nail and MDNR tag in  
 28" Oak  
 S65°W 29.36' Set nail and MDNR tag  
 in 8" Oak

Signed by Gary C. Bilow  
 Surveyor's Michigan License No. 26453

Date 3/8/91

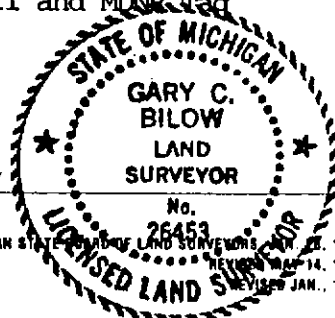

FORM APPROVED BY MICHIGAN STATE BOARD OF LAND SURVEYORS, JAN. 28, 1971  
 REVISED JAN. 1983