

**SURVEY
REMONUMENTATION**

APR 29 1999

**ALLEGAN COUNTY REMONUMENTATION
LAND CORNER RECORDATION CERTIFICATE
FILING REQUIREMENT OF ACT 74, MICH. P. A. 1970**

FILED

LIBR0007 PAF096

SECTION

FOR CORNERS IN:
ALLEGAN COUNTY

1. Public Land Survey

LOCATED IN: T...1N... R...13W... CORNER CODE # ...C-11...

SEC. COR COMMON TO SEC. 29, 30, 31 & 32 TROWBRIDGE TWP.

2. Property Controlling in section

3. Miscellaneous Property in Sec.

4. Lot No., Recorded Plat.....

5. Private Claims.....

1/28/1999 2:44:39 PM

JOYCE A. WATTS
REGISTER OF DEEDS
ALLEGAN COUNTY, MICH

REGISTER OF DEEDS STAMP & FILE NUMBER

	A	B	C	D	E	F	G	H	I	J	K	L	M
2	6	5	4	3	2	1							
3													
4	7	8	9	10	11	12							
5													
6	16	17	16	15	14	13							
7													
8	19	20	21	22	23	24							
9													
10	30	29	28	27	26	25							
11													
12	31	32	33	34	35	36							
13													

I, Raymond Moored in a field survey on Aug. 5, 1998 do hereby state that under requirements of P.A 74, Michigan P.A of 1970, corner points mentioned in lines 1 and 2 above were in conformance with regulations and rules therefore as required in the current manual of survey instructions of the United States Department of the Interior, Bureau of Land Management or by a decree of a Court of Law and/or that the corner points mentioned in the lines 3, 4, and 5 above were in conformance with the rules of the Michigan Board of Land Surveyors or by a Decree of a Court of Law; established, monumented, recovered, found as expressed below.

Note: Not more than 2 corners, all the same town and range, may be recorded on this certificate.

A. Description of original monument and accessories and/or subsequent restoration:

SEE BACK OF SHEET FOR CORNER HISTORY

APPROVED REMONUMENTATION CORNER
P.A. 345 OF 1990
ALLEGAN COUNTY
DATE APPROVED SEPT. 8, 1998
COUNTY REP. *[Signature]*

B. Description of corner evidence found and/or method applied in restoring or reestablishing corner:

FOUND 3/4" IRON IN MON. BOX PER NUMBER 2 - 4 ON BACK OF SHEET
SET 3/4" X 24" ALLEGAN COUNTY REMON IRON W/ CAP IN MON. BOX IN PLACE OF FOUND CORNER.

ACCEPTED POSITION AS A CAREFUL AND FAITHFUL PERPETUATION OF THE POSITION OF THE ORIGINAL CORNER.

PEER GROUP APPROVED SEPT. 8, 1998


C. Description of monument for corner and accessories established to perpetuate locating the position of the corner:

SET STANDARD ALLEGAN COUNTY REMONUMENTATION IRON WITH CAP IN MON BOX.
-FD. NAIL IN NE SIDE 22" MAPLE N40°W 42.56'
-FD. NAIL IN SW SIDE 18" MAPLE S35°E 42.12'
-NAIL & TAG IN NW SIDE 20" ELM S50°W 66.72
-NAIL & TAG IN N SIDE 30" MAPLE N20°E 40.10
-0.8' NORTH OF CENTERLINE 102nd AVENUE

Raymond Moored

Date 9/18/98

Surveyors License No. 26463

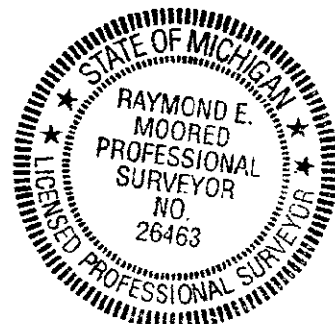

SURVEY
REMONUMENTATION

APR 29 1953

SECTION

GOVERNMENT CORNER HISTORY

SECTION CORNER COMMON TO SECTIONS 29, 30, 31 & 32
TOWN 1 NORTH, RANGE 13 WEST

C-11

1. G.L.O.

80.00 SET POST COR SECS 29, 30, 31 & 32
BEECH 14 N65W 13
BEECH 6 S601/2E 20

2. DONALD RATEKIN, RECORDED SURVEY, LIBER 814 PAGE 132, 06-22-72

IRON
10" MAPLE S35°E 42.18'
24" MAPLE S 5° E 49.62'
32" MAPLE N45°W 42.76'

3. DONALD RATEKIN, L.C.R.C., RECORDED LIBER 1 PAGE 356, 07-25-72

FOUND 1" IRON
PK NAIL 10" MAPLE S35°E 42.18'
PK NAIL 24" MAPLE S05°E 49.62'
PK NIAL 32" MAPLE N45°W 42.76'

4. DONALD RATEKIN, RECORDED SURVEY, LIBER 899 PAGE 267, 03-04-75

FD. 3/4" IRON IN MON. BOX
PK NAIL 10" MAPLE S35°E 42.18'
PK NAIL 24" MAPLE S05°E 49.62'
PK NAIL 32" MAPLE N45°W 42.76'

5. SECTION CARDS

WIGHTMAN MOORED, INC.
SE CORNER FD 3/4" IRON IN MON BOX
10" MAPLE S35°E 42.18'
24" MAPLE S05°E 49.62'
32" MAPLE N45°W 42.76'

LIBER 007 PAGE 97