

**SURVEY  
REMONUMENTATION**

APR 29 1999

**ALLEGAN COUNTY REMONUMENTATION  
LAND CORNER RECORDATION CERTIFICATE  
FILING REQUIREMENT OF ACT 74, MICH. P. A. 1970**

FILED

LIBR0007 PAGED 99

**SECTION**

FOR CORNERS IN: ALLEGAN COUNTY	LOCATED IN:	CORNER CODE #
1. Public Land Survey	T. 1N. R. 13W	D-11
1/4 SEC. COR COMMON TO SEC. 29 & 32 TROWBRIDGE TWP.	T. .... R. ....	.....
	T. .... R. ....	.....
	T. .... R. ....	.....
2. Property Controlling in section	S. .... T. .... R. ....	.....
	S. .... T. .... R. ....	.....
3. Miscellaneous Property in Sec.	S. .... T. .... R. ....	.....
4. Lot No. ...., Recorded Plat. ....		
5. Private Claims. ....		

1/28/1999 2:44:39 PM

JOYCE A. WATTS  
REGISTER OF DEEDS  
ALLEGAN COUNTY, MICH

REGISTER OF DEEDS STAMP & FILE NUMBER

	A	B	C	D	E	F	G	H	I	J	K	L	M
2	6	5	4	3	2	1							
3													
4	7	8	9	10	11	12							
5													
6	16	17	16	15	14	13							
7													
8	19	20	21	22	23	24							
9													
10	30	29	28	27	26	25							
11		●											
12	31	32	33	34	35	36							
13													

I, Raymond Moored in a field survey on Aug. 5, 1998 do hereby state that under requirements of P.A 74, Michigan P.A of 1970, corner points mentioned in lines 1 and 2 above were in conformance with regulations and rules therefore as required in the current manual of survey instructions of the United States Department of the Interior, Bureau of Land Management or by a decree of a Court of Law and/or that the corner points mentioned in the lines 3, 4, and 5 above were in conformance with the rules of the Michigan Board of Land Surveyors or by a Decree of a Court of Law; established, monumented, recovered, found as expressed below.

Note: Not more than 2 corners, all the same town and range, may be recorded on this certificate.

A. Description of original monument and accessories and/or subsequent restoration:

SEE BACK OF SHEET FOR CORNER HISTORY

APPROVED REMONUMENTATION CORNER  
P.A. 345 OF 1990  
ALLEGAN COUNTY

DATE APPROVED SEPT. 8, 1998  
COUNTY REP. W. F. Van Oort

B. Description of corner evidence found and/or method applied in restoring or reestablishing corner:

FOUND 3/4" IRON PIPE IN MON. BOX PER NUMBERS 2 - 7 ON BACK OF SHEET  
SET 3/4" X 24" ALLEGAN COUNTY REMON IRON W/ CAP IN MON. BOX IN PLACE OF FOUND CORNER.

ACCEPTED POSITION AS A CAREFUL AND FAITHFUL PERPETUATION OF THE POSITION OF THE ORIGINAL CORNER.


PEER GROUP APPROVED SEPT. 8, 1998

C. Description of monument for corner and accessories established to perpetuate locating the position of the corner:

SET STANDARD ALLEGAN COUNTY REMONUMENTATION IRON WITH CAP IN MON BOX.  
-NAIL & TAG IN NE SIDE P POLE N50W 52.43'  
-NAIL & TAG IN NE SIDE P POLE S45E 57.43'  
-NAIL & TAG IN NW SIDE P POLE N40E 80.08'  
-NE CORNER STORE (FNDN) S50W 81.38'

Raymond Moored Date 9/18/98

Surveyors License No. 26463

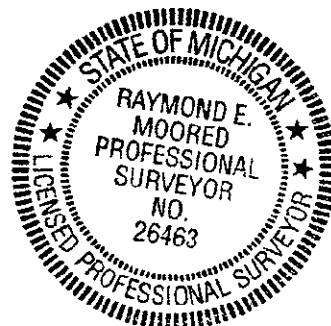

APR 29 1955

GOVERNMENT CORNER HISTORY

SECTION

SECTION CORNER COMMON TO SECTIONS 29 & 32  
TOWN 1 NORTH, RANGE 13 WEST

D-11

1. G.L.O.

WEST CORRECT BETWEEN SEC 29 & 32, 39.69 SET QR. SEC POST  
BEECH 24 N49W 5  
BEECH 12 S26W 25

2. DONALD RATEKIN, BOUNDARY SURVEY, 05-16-72

1" IRON  
NE CORNER STORE S60°W 80.67  
POWER POLE N43°E 42.75  
POWER POLE S36°E 46.77

3. DONALD RATEKIN, L.C.R.C. LIBER 1 PAGE 207, 04-18-72

FOUND 1" IRON IN MONUMENT BOX  
NE COR. STORE S60°W 80.67  
P. POLE N43°E 42.75  
P. POLE S36°E 46.77

(SAME WITNESSES SHOWN ON BOUNDARY SURVEY BY JOHN DILLINGHAM, 12-05-78)

4. DONALD RATEKIN, BOUNDARY SURVEY, 04-21-77

3/4" GAS PIPE IN MON. BOX  
NE COR STORE S60°W 80.67  
SE COR CHURCH N51°W 62.42  
POWER POLE N43°E 42.75  
POWER POLE S36°E 46.77

5. DONALD BISELL, L.C.R.C. RECORDED LIBER 003 PAGE 329, 02-23-82

FOUND 3/4" PIPE IN MONUMENT BOX  
NE CORNER STORE S60°W 80.67  
SE CORNER CHURCH N51°W 62.42  
P. POLE N43°E 42.75  
P. POLE S36°E 46.77

6. SHERIDAN SURVEYING CO., RLS JAMES MILLER, RECORDED SURVEY LIBER 1461 PAGE 884, 12-02-93

S1/4 COR, MON BOX W/3/4" PIPE  
NE COR. STORE S60°W 80.67  
SE COR. CHURCH N51°W 62.42  
P. POLE N43°E 42.75  
P. POLE S36°E 46.77

7. SECTION CARDS

WIGHTMAN MOORED, INC.

N 1/4 POST RD MAPS

1" IRON IN MON BOX

NE COR STORE S60°W 80.67

SE COR CHURCH N51°W 62.42 PP

P. POLE N43°E 42.75

P. POLE S36°E 46.77

HOLLAND ENGINEERING

FD 3/4" PIPE IN MB

NE COR STORE S60W 80.67

SE COR CHURCH N51W 62.42

PP N43E 42.77

PP S36E 46.77

LIBER 007 PAGE 100